

Ellis

KANSAS

FORM 51 IOM 12-46 PETROL

Section 24 Township 11 Range 18-W

Well No. #6 Marshall "E"

Company Lario Oil & Gas
Burnett

NORTH

WEST

EAST

SOUTH

0

13

KANSAS

Ellis county

Sec. 24 Twp. 11 R. 18W

Well No. 6 Marshall "E" Farm

Lario Oil & Gas Company


Burnett Pool

 Ft. from N. Line

330 Ft. from S. Line

 Ft. from E. Line

330 Ft. from W. Line

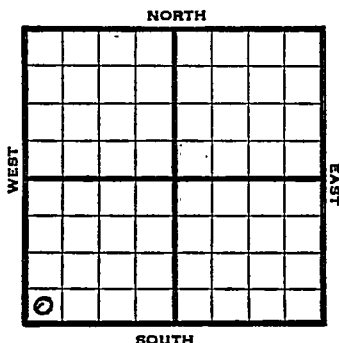

SW/c

1947

Elev. 1981' REPORT

6/25

Location

7/1

8" @ 1234
WOC

7/8

Drlg 3200'

7-16

Lansing 3212
Arbuckle 3517
80 TD
5" @ 3579
36 shots 3513-21
5 " 3520-21

7/22

2900' oil in 2 hrs.

7/30

Arb. 3517'
5" @ 3579'
Simp. 3499'
Perf. 3513-21'
Echo Pot. 3000
36.0 Gr.
TD 3580'

COMPLETED

Map No. _____ Sec. 24 Twp. 11 R. 18W

Well No. 6 Marshall "E"

Lario Oil & Gas

Company

FIRST REPORT

Contractor

SW/C


SECTION PLAT

_____ Ft. from N. Line

330 Ft. from S. Line

_____ Ft. from E. Line

330 Ft. from W. Line

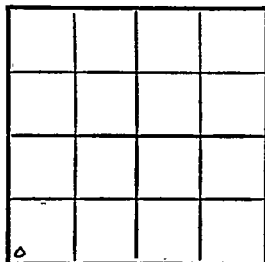

Ellis County

Location X

Rig up

Drilling and Remarks:

RECORD

Cased _____ in., _____ ft.

Sand _____

Gas _____

Oil _____

Total Depth _____

PRODUCTION

1st 24 hrs. Nat. _____

1st 24 hrs. after shot _____

Gas _____ Cu. Ft.

Dry Hole _____

Abandoned _____

Date

JUN 25 1947

19

S. J. LEWIS

Scout


KansasMap No. 71 Sec. 24 Twp. 11 R. 18WWell No. 6 Marshall "E"Lario Oil & Gas

Company

COMPLETE

Contractor

SW/C

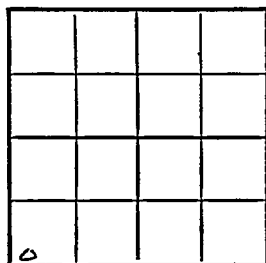E 1, 1987
SECTION PLAT Ft. from N. Line330 Ft. from S. Line Ft. from E. Line330 Ft. from W. LineEllis CountyLocation Rig up

Drilling and Remarks:

Ac 405175-103579Surf. 8499 T.O. 3580Ref. 8518-21Ech 100086-2-4**RECORD**Cased in., ft.Sand Gas Oil Total Depth **PRODUCTION**1st 24 hrs. Nat. 1st 24 hrs. after shot Gas Cu. Ft.Dry Hole Abandoned

Date

JUL 30 1947

19

S. J. LEWIS

Scout