

KANSAS

Ellis

FORM 51 IOM 12-46 PETROL

Section 24 Township 11 Range 18-W

Well No. 9 Marshall "E"

Company Lario Oil & Gas

Burnett Pool

NORTH

WEST

EAST

		0					

SOUTH

14

KANSAS

Ellis

Sec. 24 Twp. 11 R. 18W

Well No. #9 Marshall "E" Farm


Lario Oil & Gas Company
Burnett

_____ Ft. from N. Line

330 Ft. from S. Line

990 Ft. from E. Line

_____ Ft. from W. Line

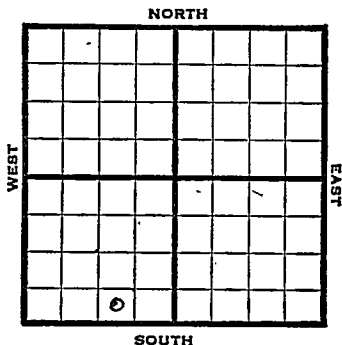

SW SE SW

1947

Elev. 1952' REPORT

10/1

8" @ 1196'
Anhy. 1189'
Drlg. 2787'

10/8

Lansing 3173'
Simpson 3451'
Arbuckle 3471'
TD 3526'
5" @ 3516'
RUST

10/15

8 shots. 3501-03'
Swab 40 bbls. oil PH 4 hrs.

10/22

"

10/29

Arbuckle 3484'
5" @ 3529'
Perf. 8 shots 3501-03
Echo Pot 3000
TD 3539'
Gravity 38

COMPLETED

Map No. _____ Sec. 24 Twp. 11 R. 18W

Well No. 9 Marshall "E"

Lario Oil & Gas Company

FIRST REPORT

Contractor

SW SE SW

SECTION PLAT

_____ Ft. from N. Line

330 Ft. from S. Line

990 Ft. from E. Line

_____ Ft. from W. Line

Ellis County

Location _____

Rig up _____

Drilling and Remarks:

8" @ 1196

anhy 1189

drlg. 2787

RECORD

Cased _____ in., _____ ft.

Sand _____

Gas _____

Oil _____

Total Depth _____

PRODUCTION

1st 24 hrs. Nat. _____

1st 24 hrs. after shot _____

Gas _____ Cu. Ft.

Dry Hole _____

Abandoned _____

Date

OCT 1 1947 19

S. J. LEWIS Scout

Map No. 71 Sec. 24 Twp. 11 R. 18W

Well No. 9 Marshall "E"

Lario Oil & Gas Company

COMPLETE

Contractor

SW SE SW

E. J. 1952
SECTION PLAT

_____ Ft. from N. Line

330 Ft. from S. Line

990 Ft. from E. Line

_____ Ft. from W. Line

Ellis County

Location _____

Rig up _____

Drilling and Remarks:

Per 84874

5-11-03529

Per 84874 to 0501-03

E. J. 1952

03529

RECORD

Cased _____ in., _____ ft.

Sand _____

Gas _____

Oil _____

Total Depth 2538

PRODUCTION

1st 24 hrs. Nat. _____

1st 24 hrs. after shot _____

Gas _____ Cu. Ft.

Dry Hole _____

Abandoned _____

Date

OCT 29 1947 19

S. J. LEWIS

Scout