

Section 24 Township 11 Range 20W

Well No. #1 Davis

Company Herndon Drlg.

NORTH

①							

13

WEST

EAST

SOUTH

Ellis

Sec. 24 Twp. 11 R. 20 W.

Well No. # 1 Davis Farm

Herndon Drlg. Company

Herndon Drlg. Contractor

Wildcat

Ft. from N. Line


330 Ft. from S. Line

Ft. from E. Line

330 Ft. from W. Line

SW SW SW

Amerada DHM

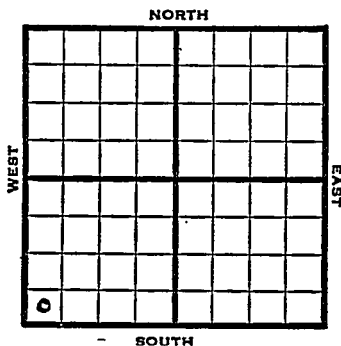

1951

Elev. 2107' REPORT

3/14

Spud 3-9-51
8" @ 270'
Drlg. 2450'

3/28

Spud 3-9-51
D & A TD 3775'
8" @ 270' Heeb 3358', Lans 3377',
DST 3477-92 open 1 hr. Rec. 200' wtr.
DST 3709-17 open 1/2 hr. Rec. 9' mud
& SSO, Arb. 3708'
TD 3775' D & A

ABANDONED

