


DX 78-1

Section 24 Township 11 Range 20W

Well No. 1 Davis & Howard

Company Eldorado Ref

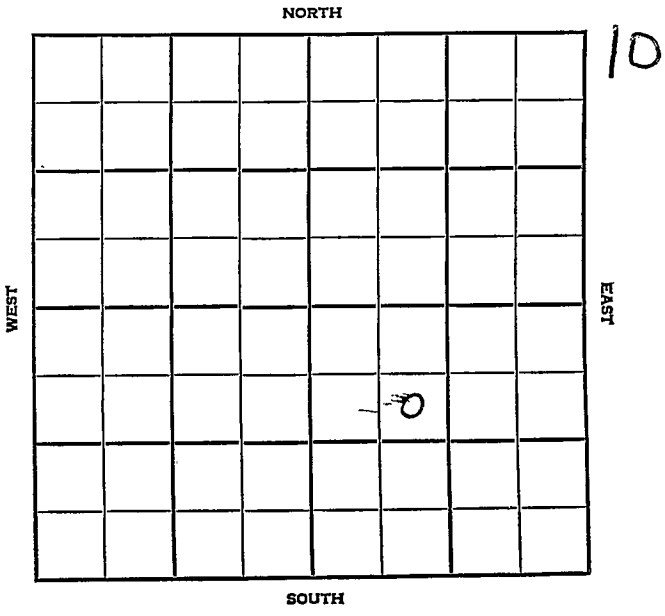


Ellis KANSAS

SEC.	TWP.	R.
24	11	20W

WELL NO. \_\_\_\_\_  
 1 Davis & Howard FARM  
 COMPANY \_\_\_\_\_  
 El Dorado  
 CONTRACTOR Wildcat

990 \_\_\_\_\_ Ft. from N. Line  
 \_\_\_\_\_ Ft. from S. Line  
 \_\_\_\_\_ Ft. from E. Line  
 990 \_\_\_\_\_ Ft. from W. Line

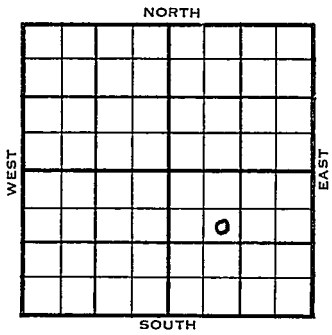

SE NW SE

	ELEVATION	REPORT
1954	1978	

7/7  
 7/21  
 8/4

Location  
 8" @ 319  
 Drlg. 500'  
 Spud 7-20-54 - D&A  
 TD 3602'  
 8" @ 319'  
 Heeb 3224', Tor 3244', Lans 3265'  
 DST 3332-62', opn 3/4 hrs., rec. 180'  
 sw, 990#  
 Cong 3535', Simp 3570', Arb. 3587'  
 TD 3602'  
 D&A

**ABANDONED**

County **Ellis** State **Kansas**

Sec. **24** (Blk.) **11** (Sur.) **20W** Map No.

Operator **Eldorado Ref.**

Well No. **1** Farm **Davis & Howard**

Elev. Location **SE NW SE**


**FIRST REPORT**

**990** Ft. From **N** Line **SE**

**990** Ft. From **W** Line **Quarter**

**JUL 7 1954**

1st. Report

Completion

Remarks

Spudding Date

Drlg. Data **Wildcat**

**Location**

