

KANSAS


Ellis

Form 51-5M-7-40-Palace

Section 24 Township 11 Range 17-W

Well No. 2 Colahan "C"

Company Cities Service Oil

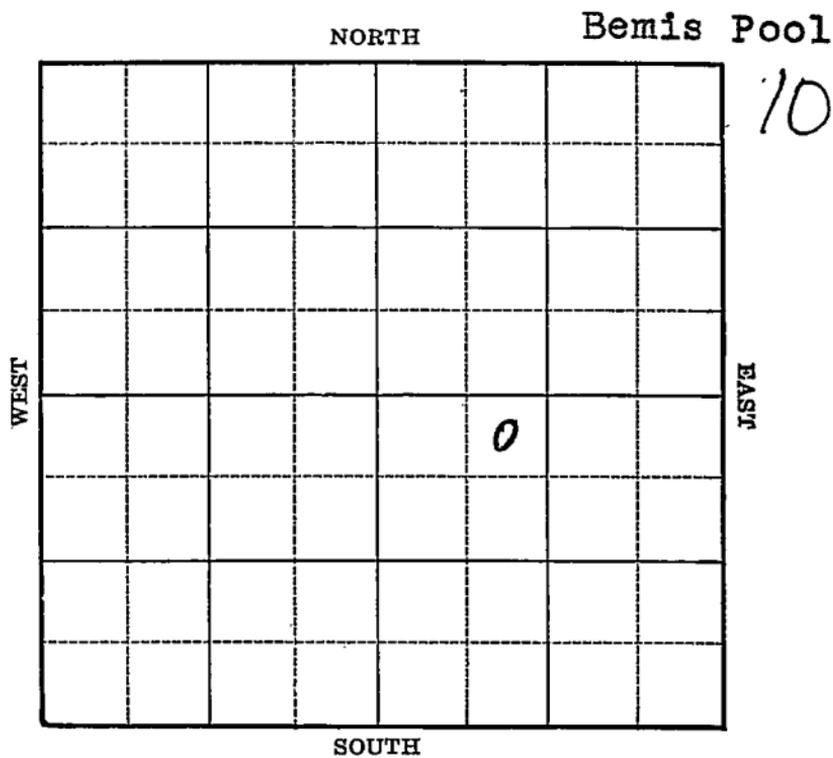

Sec. 25 24 Twp. 11 R. 17-W

Well No. #2 Colahan "C" Farm _____

Cities Service Oil Company _____


(Benis)

330 Ft. from N. Line

_____ Ft. from S. Line

_____ Ft. from E. Line

99.0 Ft. from W. Line

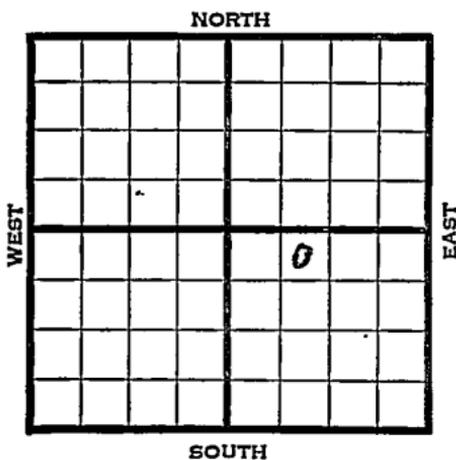

Elev. 1923

1941	REPORT
2/12	Rotary.
2/20	8" - 1075' Drlg. 1950'
2/27	Drlg. 3179'
3/6	Arb. 3396-97& T.D. 5" - 3397'
	RUST.
3/10	"
3/20	"
3/27	T.D. 3402' 2850' oil. 500 acid.
4/2	Arb. 3396'
	5" - 3397'
	T.D. 3402'
	500 acid.
	Echometer potential 13,343 bbls.
	Maximum 3000 bbls.
	33.5 Gravity
	COMPLETED

Ellis

Russell

KANSAS

Form 26—200 Bks.—1-40—Palace

Map No. 71 Sec. 24 Twp. 11 R. 17W

Well No. 2 Colahan "C"

Cities Service Oil Company

~~LOG SHEET REPORT~~ Contractor

FIRST REPORT

NE NW SE

330 Ft. from N. Line

_____ Ft. from S. Line

_____ Ft. from E. Line

990 Ft. from W. Line

BEMIS POOL

SECTION PLAT

		o	

Location _____

Rig up _____

Drilling and Remarks:

Reported in

25-11-17W.

RECORD

Cased _____ in., _____ ft.

Sand _____

Gas _____

Oil _____

Total Depth _____

PRODUCTION

1st 24 hrs. Nat. _____

1st 24 hrs. after shot _____

Gas _____ Cu. Ft.

Dry Hole _____

Abandoned _____

FIRST REPORT

Date

FEB 1 1941 19

S. J. LEWIS

Scout

Map No. 71 Sec. 24 Twp. 11 R. 17W

Well No. 2 Colahan "C"

Cities Service Oil Company

~~COMPLETED~~ Contractor

SECTION PLAT

NE NW SE
330 Ft. from N. Line

_____ Ft. from S. Line

_____ Ft. from E. Line

990 Ft. from W. Line

BEMIS POOL

Location _____

Rig up _____

Drilling and Remarks:

Ar 8396
5" @ 8397
500 acid
Echo 813343
Wax 3000

33 5 gr

RECORD

Cased _____ in., _____ ft.

Sand _____

Gas _____

Oil _____

Total Depth 3402

PRODUCTION

1st 24 hrs. Nat. _____

1st 24 hrs. after shot _____

Gas _____ Cu. Ft.

Dry Hole _____

Abandoned _____

Date

APR 2 1941

S. J. LEWIS Scout