

# KANSAS


Ellis

FORM 51 5M 4-41 PETROL

Section 24 Township 11 Range 17W

Well No. #4 Colahan "C"

Company Cities Service Oil

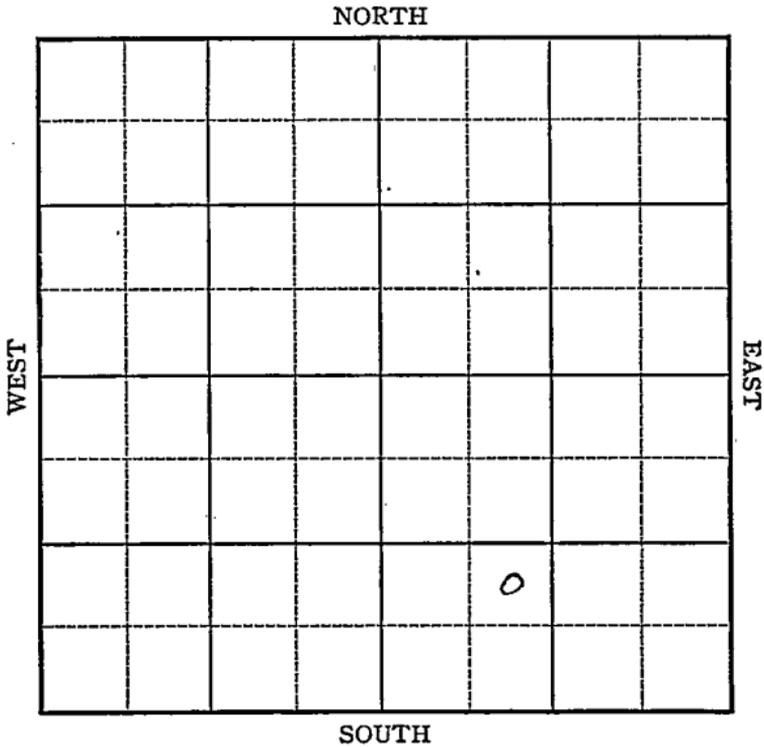



Map No. 71 Sec. 24 Twp. 11 R. 17WWell No. 4 Colahan "C"Cities Service Oil Company

Contractor

## FIRST REPORT

## SECTION PLAT

NE SW SE  
\_\_\_\_\_ Ft. from N. Line990 Ft. from S. Line

\_\_\_\_\_ Ft. from E. Line

990 Ft. from W. Line

		o	

## BEMIS POOL

Location X

Rig up \_\_\_\_\_

Drilling and Remarks:

## RECORD

Cased \_\_\_\_\_ in., \_\_\_\_\_ ft.

Sand \_\_\_\_\_

Gas \_\_\_\_\_

Oil \_\_\_\_\_

Total Depth \_\_\_\_\_

## PRODUCTION

1st 24 hrs. Nat. \_\_\_\_\_

1st 24 hrs. after shot \_\_\_\_\_

Gas \_\_\_\_\_ Cu. Ft.

Dry Hole \_\_\_\_\_

Abandoned \_\_\_\_\_

Date

JUN 25 1941

19

S. J. LEWIS

Scout

Map No. 71 Sec. 24 Twp. 11 R. 17W

Well No. 4 Colahan "C"

Cities Service Oil Company

COMPLETED Contractor

**SECTION PLAT**

NE SW SE

\_\_\_\_\_ Ft. from N. Line

990 Ft. from S. Line

\_\_\_\_\_ Ft. from E. Line

990 Ft. from W. Line

		o	

**BEMIS POOL**

**RECORD**

Location \_\_\_\_\_

Cased \_\_\_\_\_ in., \_\_\_\_\_ ft.

Rig up \_\_\_\_\_

Sand \_\_\_\_\_

Drilling and Remarks:

Gas \_\_\_\_\_

*Cor 83406*

Oil  \_\_\_\_\_

Total Depth 3413

*5" @ 3407*

*1000 acid*

*Echrd Pad 87154*

*Map 3000*

*335 Gr*

**PRODUCTION**

1st 24 hrs. Nat. \_\_\_\_\_

1st 24 hrs. after shot \_\_\_\_\_

Gas \_\_\_\_\_ Cu. Ft.

Dry Hole  \_\_\_\_\_

Abandoned \_\_\_\_\_

Date

JUL 23 1941

S. J. LEWIS Scout