


Ellis

**KANSAS**

Section 23 24 Township 11 Range 17W

Well No. #9 Colahan (C)

Company Cities Service Oil

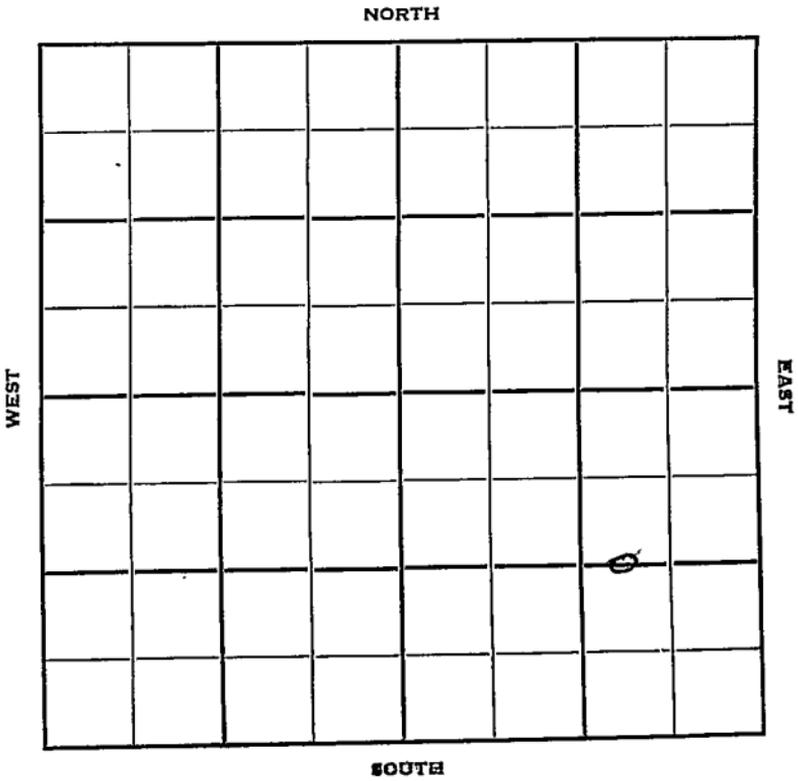

Sec. 24 Twp. 11 R. 17 W

Well No. # 9 Colahan (C) Farm

Cities Service Oil Company

Contractor


Ft. from N. Line

1320 Ft. from S. Line

990 Ft. from E. Line

Ft. from W. Line

C W/2 E/2 SE

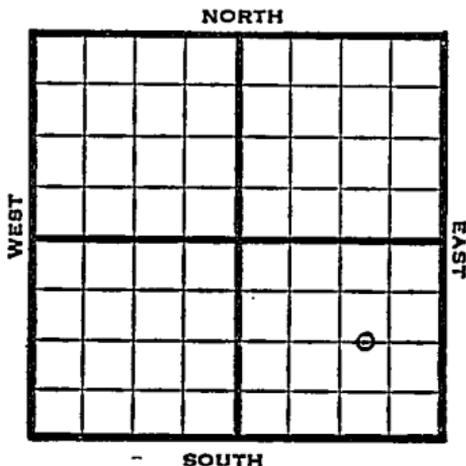

1951

Elev. 1896' REPORT

11/14

Location

12/12

Spud 11-14-51  
 Oil Well TD 3432  
 Anhy 1078  
 9-5/8" @ 1093'  
 Heeb. 3036 Dodge 3058 Lans. 3083  
 Arb. 3361  
 DST 3427-32 open 1/2 hr. rec. 300' oil  
 TD 3432 7" @ 3427 CO to 3432  
 FU 1800' oil 23 hr. 250A  
 Comp. 86 BOPD 33 BW

**COMPLETED**

County Ellis State Kansas

Sec. 23 (Blk. 11 (Sur. Rge.) 17W Map No.

Operator Cities Service Oil

Well No. 9 Farm Colahan (C)

Elev. \_\_\_\_\_ Location C W/2 E/2 SE


FIRST REPORT

1320 Ft. From S Line SE

990 Ft. From E Line Quarter

Ist. Report NOV 14 1951

Completion \_\_\_\_\_

Remarks \_\_\_\_\_

Spudding Date \_\_\_\_\_

Drlg. Data \_\_\_\_\_

**Location** \_\_\_\_\_

J. E. TYRA

Kansas

Map No. \_\_\_\_\_ Sec. 24 Twp. 11 R. 17WWell No. 9 Calahan "C"

\_\_\_\_\_ Cities Service Oil \_\_\_\_\_ Company

~~CORRECTION~~

\_\_\_\_\_ Contractor


C W L E $\frac{1}{2}$  SE

## SECTION PLAT

\_\_\_\_\_ Ft. from N. Line

1320 Ft. from S. Line990 Ft. from E. Line

\_\_\_\_\_ Ft. from W. Line

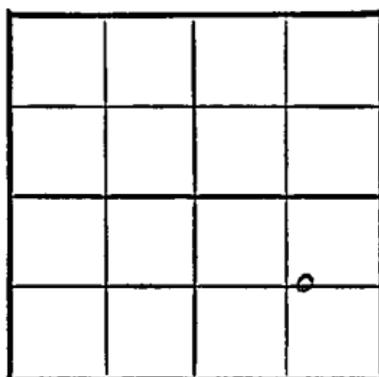

Ellis County

Location \_\_\_\_\_

Rig up \_\_\_\_\_

Drilling and Remarks:

Reported

Sec. 23-11-17W

## RECORD

Cased \_\_\_\_\_ in., \_\_\_\_\_ ft.

Sand \_\_\_\_\_

Gas \_\_\_\_\_

Oil \_\_\_\_\_

Total Depth \_\_\_\_\_

## PRODUCTION

1st 24 hrs. Nat. \_\_\_\_\_

1st 24 hrs. after shot \_\_\_\_\_

Gas \_\_\_\_\_ Cu. Ft.

Dry Hole \_\_\_\_\_

Abandoned \_\_\_\_\_

Date

NOV 21 1951

19

J. E. TYRA

Scout

