

# KANSAS

FORM 51 5M 10-41 PETROL


Trego

Section 24 Township 11 Range 21-W

Well No. #1 Haneke

Company Darby Petroleum

Wildcat

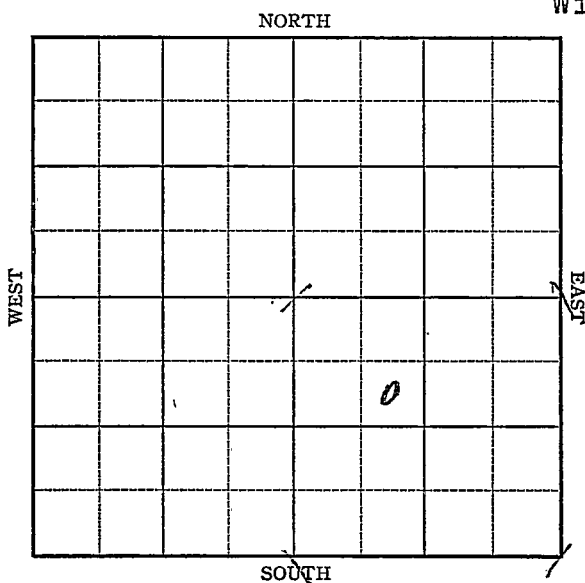

# KANSAS

## Trego

Sec. 24 Twp. 11 R. 21-W

Well No. #1. Haneke Farm

Darby Petr. \_\_\_\_\_ Company

(Wildcat)


990 Ft. from N. Line

Ft. from S. Line

Ft. from E. Line

990 Ft. from W. Line

Elev. 2217

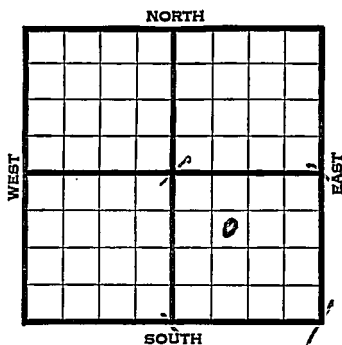

|      |                                    |
|------|------------------------------------|
| 1942 | REPORT                             |
| 3/18 | Derrick - Seismograph              |
| 3/26 | Drlg. 1575'                        |
| 4/2  | Anhy. 1626' 8" - 1632'             |
|      | Drlg. 2660'                        |
| 4/8  | Drlg. 3722'                        |
| 4/15 | Lans. 3494' B.K.C. 3736'           |
|      | Con. 3788' Arb. 3818' Spotted Sat. |
|      | No porosity 3818-33, Fair Sat.     |
|      | 3833-40' 5" - 3833' T.D. 3850'     |
|      | H.F.W. Shut down.                  |
| 4/22 | Arb. 3816'                         |
|      | 5" - 3831'                         |
|      | T.D. 3850'                         |
|      | H.F.W.                             |
|      | ABANDONED                          |

Trego


KANSAS

Map No. 70 Sec. 24 Twp. 11 R. 21WWell No. 1 HanekeDarby Petroleum CompanyFIRST REPORT Contractor

SE NW SE

990 Ft. from N. Line       Ft. from S. Line       Ft. from E. Line990 Ft. from W. Line

## SECTION PLAT

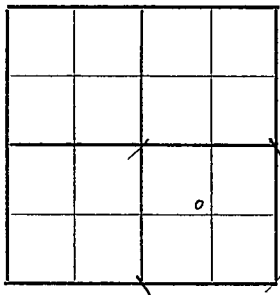

WILDCAT

Location                                 Rig up                                 Drilling and Remarks:  
DerrickSeismograph

## RECORD

Cased            in.,            ft.Sand                                 Gas                                 Oil                                 Total Depth                                 

## PRODUCTION

1st 24 hrs. Nat.                                 1st 24 hrs. after shot                                 Gas                                  Cu. Ft.Dry Hole                                 Abandoned                                 

Date

MAR 1 8 1942 19S. J. LEWIS Scout

Trego

KANSAS

Map No. 20 Sec. 24 Twp. 11 R. 21WWell No. 1 HanekeDarby Petroleum Company**ABANDONED**

Contractor

SE NW SE

990 Ft. from N. Line

Ft. from S. Line

Ft. from E. Line

990 Ft. from W. Line

## SECTION PLAT

|  |  |  |  |
|--|--|--|--|
|  |  |  |  |
|  |  |  |  |
|  |  |  |  |
|  |  |  |  |

WILDCAT

Location

Rig up

Drilling and Remarks:

*CR 83816**5" C 3831**HPW*

## RECORD

Cased \_\_\_\_\_ in., \_\_\_\_\_ ft.

Sand \_\_\_\_\_

Gas \_\_\_\_\_

Oil \_\_\_\_\_

Total Depth *3850*

## PRODUCTION

1st 24 hrs. Nat. \_\_\_\_\_

1st 24 hrs. after shot \_\_\_\_\_

Gas \_\_\_\_\_ Cu. Ft.

Dry Hole \_\_\_\_\_

Abandoned \_\_\_\_\_

Date

APR 22 1942 19 S. J. LEWIS Scout