

KANSAS


Form 51-5M-7-39-Palace

Ellis

Section 24 Township 11 Range 17-W

Well No. #15 Colahan

Company Cities Service Oil

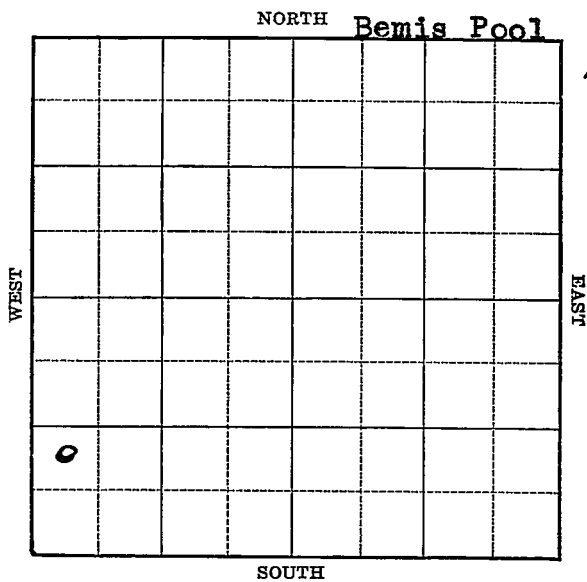

KANSAS

Ellis

Sec. 24 Twp. 11 R. 17-WWell No. #15 Colahan Farm

Cities Service Oil

Company

(Bemis)

Ft. from N. Line

990


Ft. from S. Line

Ft. from E. Line

330

Ft. from W. Line

Elev. 2089

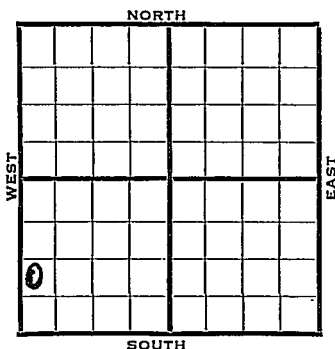

1940	REPORT
6/12	Location
6/20	Drlg. 180'
6/27	8" - 1110' Drlg. 2280'
7/3	Drlg. 2910'
7/11	Arb. 3554' T.D. 3566' Run 5".
7/18	T.D. 3665' 5" - 3664'
	48 shots 3633-40' 2975' oil 40 minutes.
7/24	Arb. 3554'
	5" - 3664'
	T.D. 3665'
	48 shots 3633-40'
	Echometer potential 35,430 bbls.
	Maximum 3000 bbls.
	COMPLETED

Ellis

KANSAS

Map No. 71 Sec. 24 Twp. 11 R. 17WWell No. 15 ColahanCities Service Oil Company

Contractor

FIRST REPORT

SECTION PLAT

NW SW SW

Ft. from N. Line

990 Ft. from S. Line

Ft. from E. Line

330 Ft. from W. Line

BEMIS POOL

o			

Location X

Rig up

Drilling and Remarks:

RECORD

Cased _____ in., _____ ft.

Sand _____

Gas _____

Oil _____

Total Depth _____

PRODUCTION

1st 24 hrs. Nat. _____

1st 24 hrs. after shot _____

Gas _____ Cu. Ft.

Dry Hole _____

Abandoned _____

Date

JUN 12 1940 19

S. J. LEWIS Scout

Map No. _____ Sec. 24 Twp. 11 R. 17WWell No. 15 ColahanCities Service Oil Company

Contractor _____

COMPLETED

NW SW SW

_____ Ft. from N. Line

990 Ft. from S. Line

_____ Ft. from E. Line

330 Ft. from W. Line**SECTION PLAT**

BEMIS POOL

Location _____

Rig up _____

Drilling and Remarks:

*Cr 73554**5" @ 3664**48 Sk & L 3633-40**Eckman's P & Y**35430**Map 3000***RECORD**

Cased _____ in., _____ ft.

Sand _____

Gas _____

Oil _____

Total Depth 3665**PRODUCTION**

1st 24 hrs. Nat. _____

1st 24 hrs. after shot _____

Gas _____ Cu. Ft.

Dry Hole _____

Abandoned _____

Date

JUL 24 1940₁₉S. J. LEWIS Scout