

KANSAS

Form 51-5M-7-39-Palace,

Ellis

Section 24 Township 11 Range 17-W

Well No. #8 Colahan

Company Cities Service Oil

Bemis Pool

NORTH

WEST

EAST

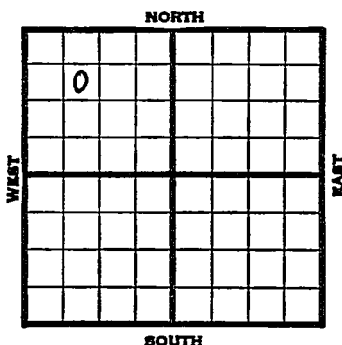
SOUTH

	0						

4

Sec. 24 Twp. 11 R. 17-WWell No. #8 Colahan FarmCities Service Oil Company

(Bemis)

990 Ft. from N. Line Ft. from S. Line Ft. from E. Line990 Ft. from W. Line

1939	REPORT
12/20	Location
12/28	"
1940	
1/4	R.U.R.
1/11	16" - 68' 8" - 1141' WOC.
1/18	Drlg. 3085'
1/25	Arb. 3543' ^{3543'} 5 $\frac{1}{2}$ " - 3549' 3544'
	T.D. 3550' RUST.
2/1	" " "
2/7	Arb. 3543' (Corrected)
	5 $\frac{1}{2}$ " - 3544'
	T.D. 3548'
	500 acid.
	Echometer potential 33,730 bbls.
	Maximum 3000 bbls.

COMPLETED

Ellis

KANSAS

Map No. 71 Sec. 24 Twp. 11 R. 17WWell No. 8 ColahanCities Service Oil

Company

Contractor

FIRST REPORT
SE NW NW990 Ft. from N. Line Ft. from S. Line Ft. from E. Line990 Ft. from W. Line**SECTION PLAT**

o			

BEMIS POOLLocation XRig up

Drilling and Remarks:

RECORDCased in., ft.Sand Gas Oil Total Depth **PRODUCTION**1st 24 hrs. Nat. 1st 24 hrs. after shot Gas Cu. Ft.Dry Hole Abandoned

Date-

DEC 20 1939
19S. J. LEWIS

Scout

Map No. 71 Sec. 24 Twp. 11 R. 17WWell No. 8 ColahanCities Service Oil Company

Contractor

COMPLETED

SE NW NW

990 Ft. from N. Line Ft. from S. Line Ft. from E. Line990 Ft. from W. Line

BEMIS POOL

SECTION PLAT

o			

Location Rig up

Drilling and Remarks:

*Core & 3543 corrected**5 1/2' C 3544**500 Acid**Echometer Pot.**33730**Maximum 3000*

RECORD

Cased in., ft.Sand Gas Oil Total Depth 3548

PRODUCTION

1st 24 hrs. Nat. 1st 24 hrs. after shot Gas Cu. Ft.Dry Hole Abandoned

Date

FEB 7 1940 19 S. J. LEWIS Scout