

KANSAS

Form 51-5M-7-39-Palace


Ellis

Section 24 Township 11 Range 17-W

Well No. #16 Colahan

Company Cities Service Oil

NORTH Bemis Pool

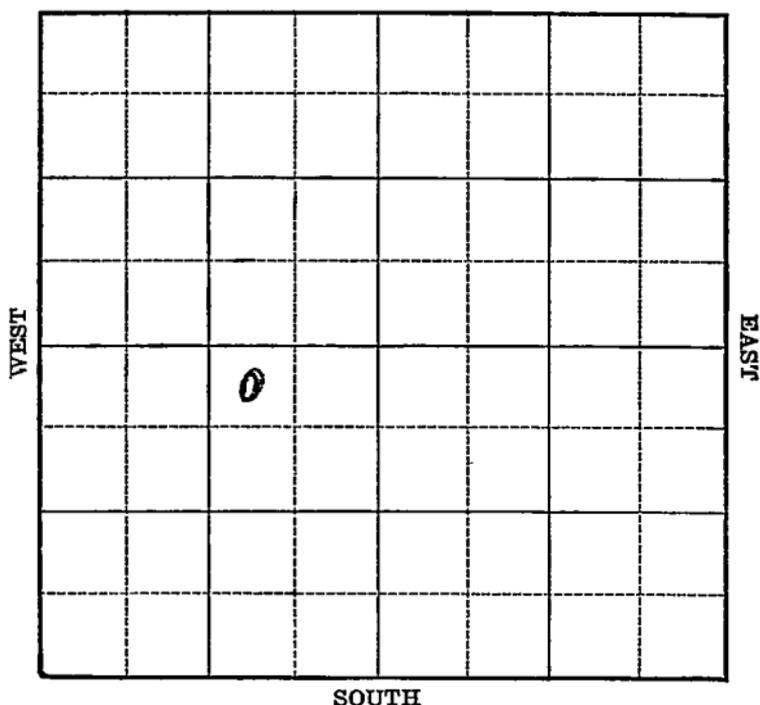

SOUTH

Map No. 71 Sec. 24 Twp. 11 R. 17W

Well No. 16 Colahan

Cities Service Oil Company

Contractor

FIRST REPORT
NW NE SW

SECTION PLAT

330 Ft. from N. Line

_____ Ft. from S. Line

990 Ft. from E. Line

_____ Ft. from W. Line

	o		

BEMIS POOL

Location X

Rig up _____

Drilling and Remarks:

RECORD

Cased _____ in., _____ ft.

Sand _____

Gas _____

Oil _____

Total Depth _____

PRODUCTION

1st 24 hrs. Nat. _____

1st 24 hrs. after shot _____

Gas _____ Cu. Ft.

Dry Hole _____

Abandoned _____

Date

JUN 26 1940 19

S. J. LEWIS Scout

Map No. 71 Sec. 24 Twp. 11 R. 13^W

Well No. 16 Colahan

Cities Service Oil Company

Contractor

COMPLETED

NW NE SW

330 Ft. from N. Line

_____ Ft. from S. Line

990 Ft. from E. Line

_____ Ft. from W. Line

SECTION PLAT

	o		

BEMIS POOL

Location _____

Rig up _____

Drilling and Remarks:

500 acid

*Depthograph
Pot. 47,200 lbs*

May, 3000 lbs

RECORD

Cased _____ in _____ ft.

Sand *Perbuckle 3440*

Gas _____

Oil _____

Total Depth 3444

PRODUCTION

1st 24 hrs. Nat. _____

1st 24 hrs. after shot _____

Gas _____ Cu. Ft.

Dry Hole _____

Abandoned _____

Date

JUL 31 1940 19

S. J. LEWIS Scout