


Section 24 Township 11 Range 25W

Well No. #1 Brown

Company Armer & Koplin

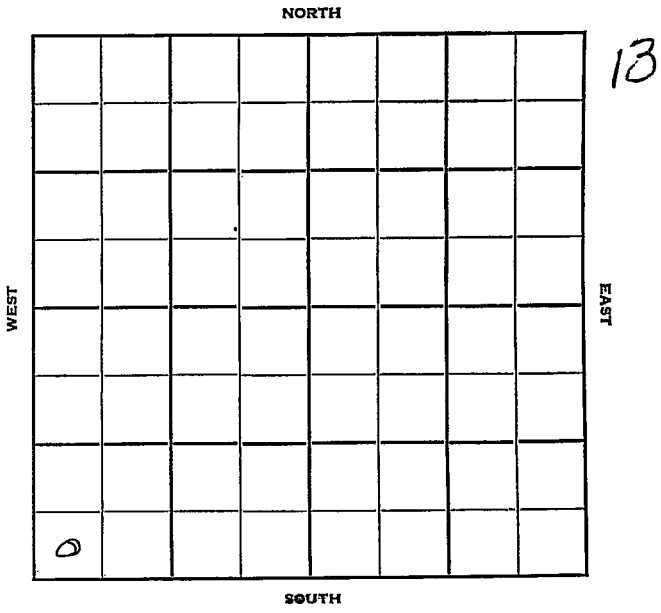

Trego

KANSAS 25-26W

Sec. 24 Twp. 11 R. 26W

Well No. #1 Brown Farm

Armer & Koplin Company

Wildcat Contractor


Ft. from N. Line

330' Ft. from S. Line

Ft. from E. Line

330' Ft. from W. Line

SW SW SW

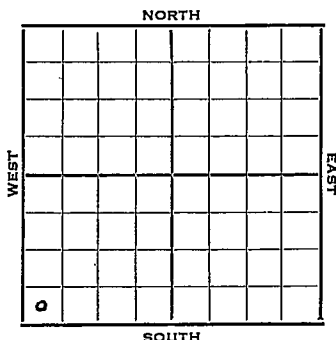

1951 Elev. 2475' REPORT

12/12 MIR

1952

1/2

Spud 12-11-51

D&A TD 4444

8" @ 250

Heeb. 3780

KC 3816

DST 3882-3922 open 45 min.

Rec. 120' wtr.

DST 4271-4303 open 15 min.

Rec. 20' mud

Cong. 4355

Miss 4372

TD 4444

D&A

ABANDONED

County Trego State Kansas

Sec. **24** (Blk. Twp.) **11** (Sur. Rge.) **25W** Map No.

Operator **Armer & Koplin**

Well No. **1** Farm **Brown**

Elev.	Location	SW	SW	SW
-------	----------	----	----	----

0 FIRST REPORT

330 Ft. From S Line SW

330 Ft. From W Line Quarter

1st. Report DEC 1 2 1951

Completion

Remarks

Spudding Date

Drig. Data Wildcat

M I R

Wildcat

J. E. TYRA

J. E. TYRA