


Section 24 Township 11 Range 23 W

Well No. # 1 Mong

Company Davis Bros & Transit Corp

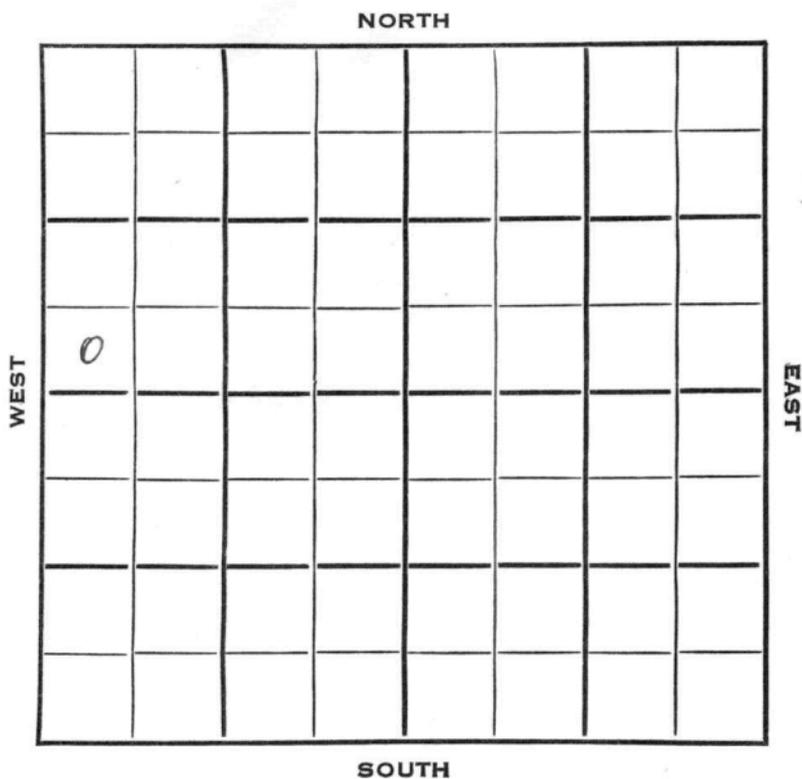

Trego KANSAS

| | | |
|------|------|-------|
| SEC. | TWP. | R. |
| 24 | 11 | 23W ✓ |

WELL NO. _____
 COMPANY 1 Mong FARM

CONTRACTOR Davis Bros. & Transit Corp.


E. Wakeeney Pool

_____ Ft. from N. Line

330 _____ Ft. from S. Line

_____ Ft. from E. Line

330 _____ Ft. from W. Line

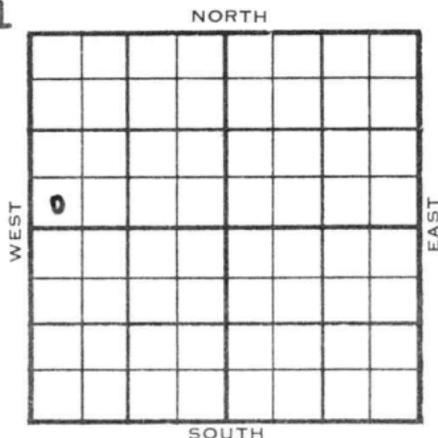

SW SW NW
 Shell - DHM

| | ELEVATION | REPORT |
|------|-----------|--------|
| 1954 | 2285 | |

5/12 Spud 5-7-54
 8" @ 175'
 Drlg. 2235'

5/19 Heeb 3515 Lans 3550
 DST 3600-10, 1 hr, 150' VSO & MCSW
 860# B KC 3802 Marm 3876'
 Drlg. 3912'

5/26 Spud 5-7-54
 D&A
 TD 4057'
 8" @ 175'
 Heeb 3515', Lans 3550'
 DST 3600-10', opn 1 hr., rec. 150'
 vso & mcsw, 860#
 B KC 3802', Marm. 3876'
 DST 3878-3920', opn 1 hr., rec.
 63' vsocm, 1040#
 TD 4057'
 Arb. 4005'
 D&A

ABANDONED

