

STATE CORPORATION COMMISSION OF KANSAS
OIL & GAS CONSERVATION DIVISION
WELL COMPLETION OR RECOMPLETION FORM
ACO-1 WELL HISTORY
DESCRIPTION OF WELL AND LEASE

Operator: License # 5693
Name W. L. Hartman Trust
Address P. O. Box 54
City/State/Zip Wichita, Kansas 67201

Purchaser

Operator Contact Person Sherry Heathman
Phone (316) 682-4568

Contractor: License # 5381
Name Big Springs Drilling, Inc.

Wellsite Geologist Phil Paschang
Phone (316) 269-9041

Designate Type of Completion
 New Well Re-Entry Workover

Oil SWD Temp Abd
 Gas inj Delayed Comp.
 Dry Other (Core, Water Supply etc.)

If **OWWO**: old well info as follows:
Operator
Well Name
Comp. Date Old Total Depth

WELL HISTORY

Drilling Method:
 Mud Rotary Air Rotary Cable

10-14-85 10-20-85 10-20-85
Spud Date Date Reached TD Completion Date

3980'
Total Depth PBSD

Amount of Surface Pipe Set and Cemented at 218 feet
Multiple Stage Cementing Collar Used? Yes No
if yes, show depth set feet
if alternate 2 completion, cement circulated
from 0 feet depth to 218' w/ 150 SX cmt
Cement Company Name
Invoice #

API NO. 15-195 - 21,793

County Trego

NW NE SW Sec 7 Twp 11S Rge 24W East West

2310 Ft North from Southeast Corner of Section
3630 Ft West from Southeast Corner of Section
(Note: Locate well in section plat below)


Lease Name Scanlon Well # 1

Field Name

Producing Formation

Elevation: Ground 2357' KB 2362'

Section Plat

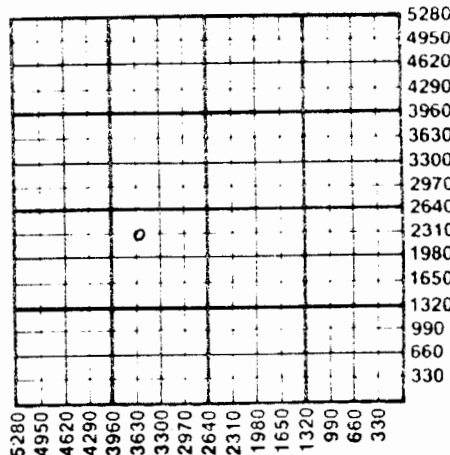

WATER SUPPLY INFORMATION

Disposition of Produced Water: Disposal
Docket # Repressuring

Questions on this portion of the ACO-1 call:

Water Resources Board (913) 296-3717

Source of Water: Hauled
Division of Water Resources Permit #

Groundwater Ft North from Southeast Corner
(Well) Ft West from Southeast Corner of
Sec Twp Rge East West

Bought from Edgar Schmidt

Surface Water Ft North from Southeast Corner
(Stream, pond etc) Ft West from Southeast Corner
Sec Twp Rge East West

Other (explain)
(purchased from city, R.W.D. #)

INSTRUCTIONS: This form shall be completed in duplicate and filed with the Kansas Corporation Commission, 200 Colorado Derby Building, Wichita, Kansas 67202, within 90 days after completion or recompletion of any well. Rule 82-3-130 and 82-3-107 apply.

Information on side two of this form will be held confidential for a period of 12 months if requested in writing and submitted with the form. See rule 82-3-107 for confidentiality in excess of 12 months. One copy of all wireline logs and drillers time log shall be attached with this form. Submit CP-4 form with all plugged wells. Submit CP-111 form with all temporarily abandoned wells.

CONFIDENTIAL

FW

SIDE TWO

Operator Name W. L. Hartman Trust Lease Name Scanlon Well # 1

Sec. 7 Twp. 11S Rge. 24W East West County Trego

WELL LOG

INSTRUCTIONS: Show important tops and base of formations penetrated. Detail all cores. Report all drill stem tests giving interval tested, time tool open and closed, flowing and shut-in pressures, whether shut-in pressure reached static level, hydrostatic pressures, bottom hole temperature, fluid recovery, and flow rates if gas to surface during test. Attach extra sheet if more space is needed. Attach copy of log.

Drill Stem Tests Taken Yes No
 Samples Sent to Geological Survey Yes No
 Cores Taken Yes No

Formation Description
 Log Sample

Name Top Bottom

NA - DST's

CASING RECORD <input checked="" type="checkbox"/> New <input type="checkbox"/> Used							
Report all strings set-conductor, surface, intermediate, production, etc.							
Purpose of String	Size Hole Drilled	Size Casing Set (in O.D.)	Weight Lbs/Ft.	Setting Depth	Type of Cement	#Sacks Used	Type and Percent Additives
Surface	12 1/4"	8 5/8"	24#	218'	60-40 POZ	150 SX	2% gel 3% ccl
PERFORATION RECORD				Acid, Fracture, Shot, Cement Squeeze Record			
Shots Per Foot	Specify Footage of Each Interval Perforated			(Amount and Kind of Material Used)		Depth	
TUBING RECORD				Liner Run <input type="checkbox"/> Yes <input type="checkbox"/> No			
Date of First Production	Producing Method <input type="checkbox"/> Flowing <input type="checkbox"/> Pumping <input type="checkbox"/> Gas Lift <input type="checkbox"/> Other (explain).....						

7-11-24W

BIG SPRINGS DRILLING, INC.

P.O. BOX 8287
MUNGER STATION
WICHITA, KANSAS 67208

SUITE 29 • 400 NORTH WOODLAWN • (316) 681-1732

October 29, 1985

W. L. Hartman Trust
P. O. Box 54
Wichita, Kansas 67201

Attn: Sherry Heathman

Re: Scanlon #1
NW NE SW
Sec. 7 - 11S - 24W
Trego County, Kansas

DRILLERS LOG

Clay, postruck, sand & shale	0'	223'
Shale	223'	925'
Sand	925'	1050'
Shale	1050'	1087'
Shale & Sand	1087'	1525'
Sand	1525'	1725'
Shale	1725'	1970'
Anhydrite	1970'	2013'
Shale	2013'	2676'
Shale & Lime	2676'	3980'
RTD	3980'	

STATE OF KANSAS

OCT 31 1985

WICHITA, KANSAS