

TYPE

AFFIDAVIT OF COMPLETION FORM

ACO-1 WELL HISTORY

SIDE ONE

Compt. _____

(Rules 82-3-130 and 82-3-107)

This form shall be filed with the Kansas Corporation Commission, 200 Colorado Derby Building, Wichita, Kansas 67202, within ninety (90) days after the completion of a well, regardless of how the well was completed.

FOR INFORMATION REGARDING THE NUMBER OF COPIES TO BE FILED AND APPLICATIONS REQUIRING COPIES OF ACO-1 FORMS SEE PAGE TWO (2), SIDE TWO (2) OF THIS FORM.

 State Geological Survey
WICHITA BRANCH

(F) ☒ Letter requesting confidentiality attached.

(C) ☒ Attach ONE COPY of EACH wireline log run (i.e. electrical log, sonic log, gamma ray neutron log etc.)***Check here if NO logs were run _____.

PLEASE FILL IN ALL INFORMATION. IF NOT AVAILABLE, INDICATE. IF INFORMATION LATER BECOMES AVAILABLE, SUBMIT BY LETTER.

LICENSE # 6889 EXPIRATION DATE June 30th, yearly

OPERATOR Oxford Exploration Company API NO. 15-195-21,353

ADDRESS 1550 Denver Club Bldg. COUNTY Trego

Denver, Colorado 80202 FIELD _____

** CONTACT PERSON David E. Park, Jr. PROD. FORMATION _____

PHONE 572-3821

PURCHASER _____ LEASE Walker

ADDRESS _____ WELL NO. #13-9-2

WELL LOCATION SE, Sec. 13 11S-24W

DRILLING Murfin Drilling Company 2310 Ft. from South Line and

CONTRACTOR _____ 990 Ft. from East Line of (E)

ADDRESS 250 N. Water, Suite 300 the SE (Qtr.) SEC 13 TWP 11S RGE 24W (W).

Wichita, KS 67202

PLUGGING Murfin Drilling Company WELL PLAT (Office Use Only)

CONTRACTOR _____

ADDRESS same as above

TOTAL DEPTH 4000' PBD _____


SPUD DATE 10-11-83 DATE COMPLETED 10-16-83

ELEV: GR 2365' DF _____ KB 2370'

DRILLED WITH (~~CABLE~~) (ROTARY) (~~WTR~~) TOOLS.

DOCKET NO. OF DISPOSAL OR REPRESSURING WELL BEING USED TO DISPOSE OF WATER FROM THIS LEASE _____

Amount of surface pipe set and cemented 213' DV Tool Used? no

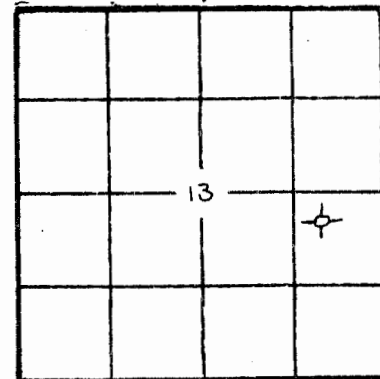

KCC _____

KGS ☒

SWD/REP _____

PLG. _____

NGPA _____

TYPE OF COMPLETION THIS AFFIDAVIT APPLIES TO: (Circle ONE) - Oil, Shut-in Gas, Gas, Dry Disposal, Injection, Temporarily Abandoned. If OWWO, indicate type of re-completion _____. Other completion _____. NGPA filing _____.

ALL REQUIREMENTS OF THE STATUTES, RULES AND REGULATIONS PROMULGATED TO REGULATE THE OIL AND GAS INDUSTRY HAVE BEEN FULLY COMPLIED WITH.

A F F I D A V I T

David E. Park, Jr., being of lawful age, hereby certifies that:

I am the Affiant, and I am familiar with the contents of the foregoing Affidavit.