

STATE CORPORATION COMMISSION OF KANSAS
OIL & GAS CONSERVATION DIVISION

WELL COMPLETION OR RECOMPLETION FORM
ACO-1 WELL HISTORY

DESCRIPTION OF WELL AND LEASE

Operator: License # 9067
Name DaMar Resources, Inc.
Address P.O. Box 70
City/State/Zip Hays, Ks. 67601

Purchaser.....

Operator Contact Person Daniel F. Schippers..
Phone 913-625-0020

Contractor: License # 4087
Name Williamson Drilling, Inc.

Wellsite Geologist Jerry Green.....
Phone 913-625-5155

Designate Type of Completion

☒ New Well ☐ Re-Entry ☐ Workover

☐ Oil ☐ SWD ☐ Temp Abd
☐ Gas ☐ Inj ☐ Delayed Comp.
☒ Dry ☐ Other (Core, Water Supply etc.)

If OWWO: old well info as follows:

Operator.....
Well Name.....
Comp. Date.....Old Total Depth.....

WELL HISTORY

Drilling Method:

☒ Mud Rotary ☐ Air Rotary ☐ Cable

..9-18-85... ..9-25-85... ..9-25-85...
Spud Date Date Reached TD Completion Date
...4005'... ..
Total Depth PBTD

Amount of Surface Pipe Set and Cemented at 21.3 feet
Multiple Stage Cementing Collar Used? ☐ Yes ☒ No
If yes, show depth set.....feet
if alternate 2 completion, cement circulated
from.....feet depth to.....w/.....SX cmt

API NO. 15-195-21-784.....

County...Trego.....

..NW.. ..NW.. ..SE.. Sec. 16.. Twp 11.. Rge. 24.. ☐ East
☒ West

2310..... Ft North from Southeast Corner of Section

2310..... Ft West from Southeast Corner of Section

(Note: Locate well in section plat below)


Lease Name Schambarger.....Well #1.....

Field Name.....

Producing Formation.....

Elevation: Ground..2398.....KB. 2403.....

Section Plat

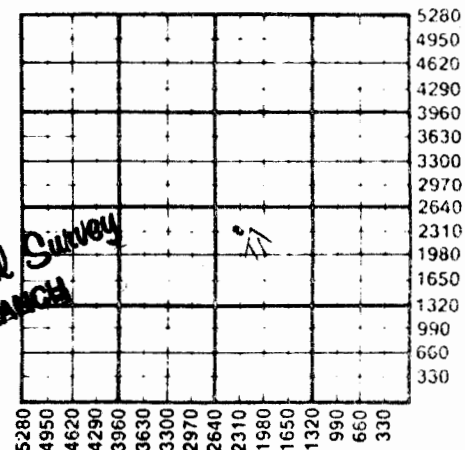

OCT 02 1985
State Geological Survey
WICHITA BRANCH

WATER SUPPLY INFORMATION

Disposition of Produced Water: ☐ Disposal
Docket # ☐ Repressuring

Questions on this portion of the ACO-1 call:

Water Resources Board (913) 296-3717

Source of Water:

Division of Water Resources Permit # Farm Prod....

☐ Groundwater.....Ft North from Southeast Corner
(Well)Ft West from Southeast Corner of
Sec Twp Rge ☐ East ☐ West

☒ Surface Water 22.75 Ft North from Southeast Corner
(Stream, pond etc) 15.10 Ft West from Southeast Corner
SW NW SE Sec 16 Twp 11 Rge 24 ☐ East ☒ West

☐ Other (explain).....
(purchased from city, R.W.D. #)

INSTRUCTIONS: This form shall be completed in duplicate and filed with the Kansas Corporation Commission, 200 Colorado Derby Building, Wichita, Kansas 67202, within 90 days after completion or recompletion of any well. Rule 82-3-130 and 82-3-107 apply.
Information on side two of this form will be held confidential for a period of 12 months if requested in writing and submitted with the form. See rule 82-3-107 for confidentiality in excess of 12 months.
One copy of all wireline logs and drillers time log shall be attached with this form. Submit CP-4 form with all plugged wells. Submit CP-111 form with all temporarily abandoned wells.