


Section 25 Township 11 Range 16-W

Well No. #1 Don Chrisler

Company Cherry & Kidd

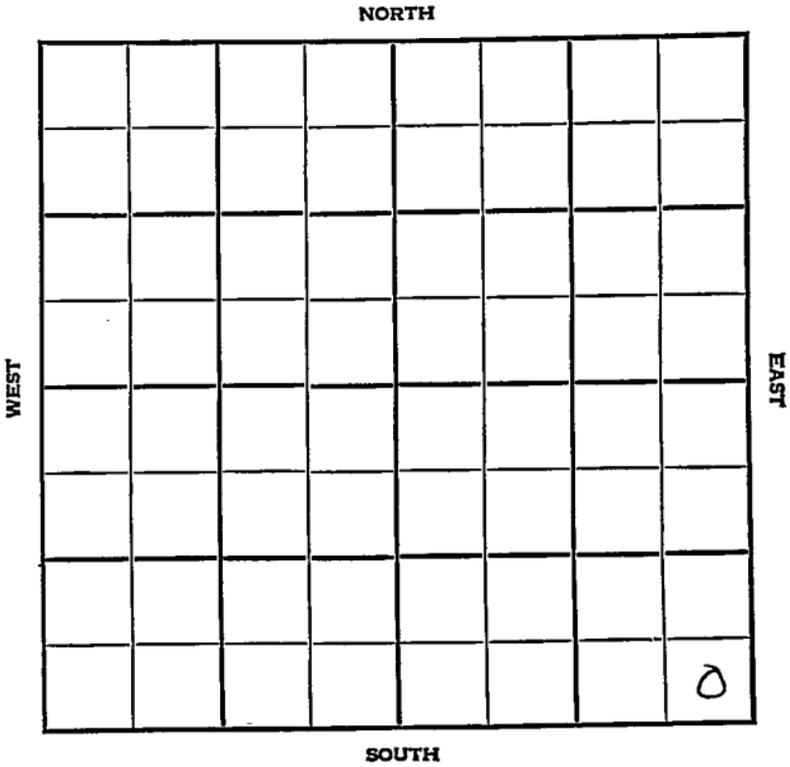

KANSAS

Ellis



Sec. 25 Twp. II R. 16W

Well No. #1 Don Chrisler Farm

Cherry & Kidd Company


_____ Ft. from N. Line

330' Ft. from S. Line

330' Ft. from E. Line

_____ Ft. from W. Line

SE/C

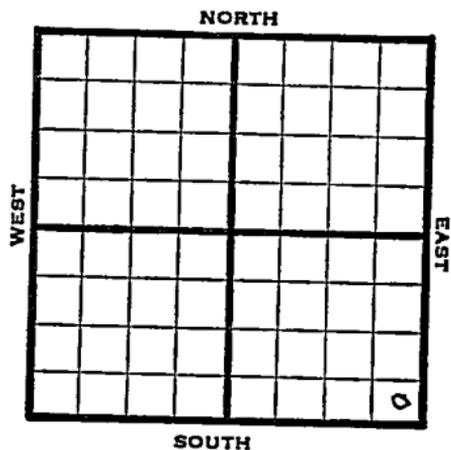

1948

Elev. 1786' REPORT

7/14

Drlg. 500'

8/19

8" @ 922'

Drlg 2625'

8/28

Lansing 3025'

Drlg 3338'

8/4

TD 3558'?

8/11

Arb. 3484'

TD 3658'

ABANDONED

Map No. _____ Sec. 25 Twp. 11 R. 16W

1 Don Chrisler

Well No. _____

Cherry & Kidd Company

FIRST REPORT Contractor

SE/C

SECTION PLAT

| | | | |
|--|--|--|--|
| | | | |
| | | | |
| | | | |
| | | | |

_____ Ft. from N. Line

330 Ft. from S. Line

330 Ft. from E. Line

_____ Ft. from W. Line

Ellis County

Location _____

Rig up _____

Drilling and Remarks:

Drig. 500

RECORD

Cased _____ in. _____ ft.

Sand _____

Gas _____

Oil _____

Total Depth _____

PRODUCTION

1st 24 hrs. Nat. _____

1st 24 hrs. after shot _____

Gas _____ Cu. Ft.

Dry Hole _____

Abandoned _____

Date

JUL 14 1948

19

S. J. LEWIS Scout

Ellis County Kansas State

Map No. 71 Sec. 25 Twp. 11 R. 16W

Well No. 1 Michaux

Cherry & Kidd Company

ABANDONED

Contractor

SE/C

E11786
SECTION PLAT

| | | | | | | | | | |
|--|--|--|--|--|--|--|--|--|---|
| | | | | | | | | | |
| | | | | | | | | | |
| | | | | | | | | | 6 |

Ft. from N. Line

330 Ft. from S. Line

330 Ft. from E. Line

Ft. from W. Line

Wildcat

Remarks:

cut 3484

7103508

Date
AUG 11 1948

Scout: S. J. LEWIS