



Russell  
11 R. 13W

Map No. \_\_\_\_\_ Sec. 25 Twp. \_\_\_\_\_ R. \_\_\_\_\_


Well No. 1- Patton  
Warren Oil  
Farm \_\_\_\_\_  
Company \_\_\_\_\_

\_\_\_\_\_ Ft. from N. Line

330 Ft. from S. Line

330 Ft. from E. Line

\_\_\_\_\_ Ft. from W. Line

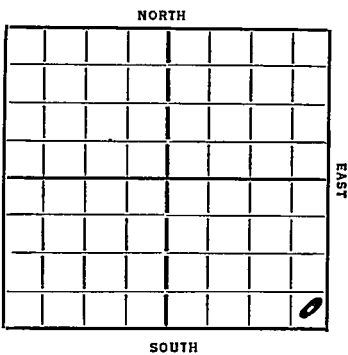

Elev. 1725

REPORT

Date	Notes
11/27	Moving In
12/6	" " Mat
12/13	Rig
12/19	Spud 370 15" 790
12/26	Blg 1000
1/2/36	" 1900
1/10	" 2450 8" 2311
1/17	" 2650
1/24	6" 2940 TD 2978 WR 6"
1/31	T Lant. 2970 6" 3004
	TD 3125 2200 g.
2/7	Blg 3355
2/14	SD 3385
2/21	TD 3390 SD
2/26	Conq 3360
	TD 3390

D & A.

**ABANDONED**

Map No. 72 Sec. 25 Twp. 11 R. 13W

Well No. 1-Bratton  
Warren oil Company

Contractor

**FIRST REPORTS**

**SECTION PLAT**

..... Ft. from N. Line  
330 Ft. from S. Line  
330 Ft. from E. Line  
..... Ft. from W. Line

			0

Location.....

Rig up.....

Drilling and Remarks:

*Moving in*

**RECORD**

Cased..... in., ..... ft.

Sand.....

Gas.....

Oil.....

Total Depth.....

**PRODUCTION**

1st 24 hrs. Nat.....

1st 24 hrs. after shot.....

Gas..... Cu. Ft.

Dry Hole.....

Abandoned.....

Date

11-27-35 192

Scout



Map No. 72 Sec. 25 Twp. 11 R. 12W

Well No. 1 - Bratton

Warren Oil Company

Contractor

**COMPLETED**

SECTION PLAT

.....Ft. from N. Line

330 Ft. from S. Line

330 Ft. from E. Line

.....Ft. from W. Line

			0

Location.....

Rig up.....

Drilling and Remarks:

D.A.

RECORD

Cased.....in., .....ft.

Sand Comp. 3360

Gas.....

Oil.....

Total Depth 3390

PRODUCTION

1st 24 hrs. Nat.....

1st 24 hrs. after shot.....

Gas.....Cu. Ft.

Dry Hole.....

Abandoned.....

Date

FEB 26 1936

192

ORVAL MANNSCHRECK

Scout