

KANSAS


Ellis

FORM 51 IOM 12-46 PETROL

Section 25 Township 11 Range 18W

Well No. 1 Marshall

Company Keyer Drlg.

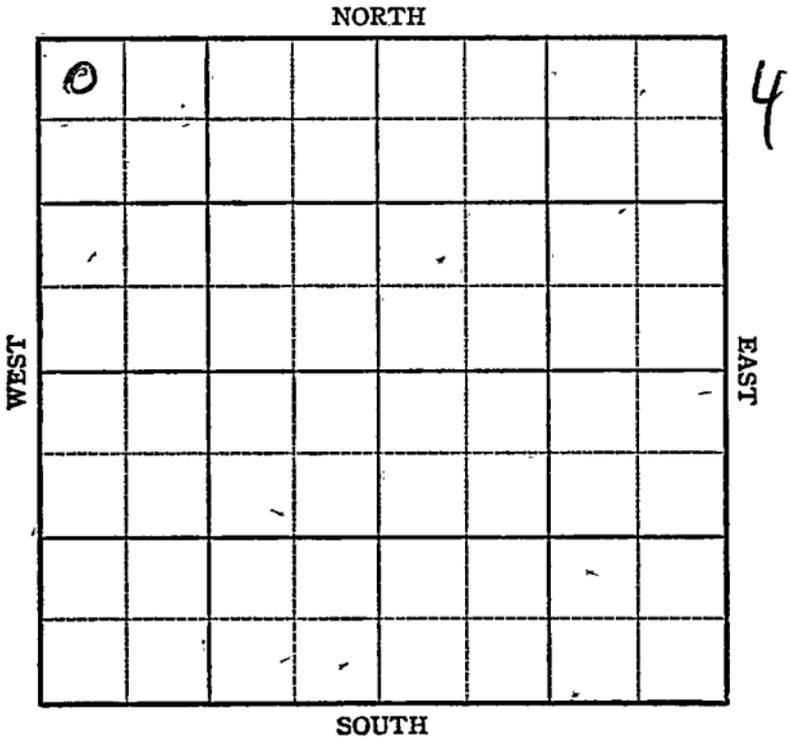

Sec. 25 Twp. 11 R. 18-W

Well No. #1 Marshall Farm


Keyer Drlg Company  
Burnett

330 Ft. from N. Line

\_\_\_\_\_ Ft. from S. Line

\_\_\_\_\_ Ft. from E. Line

330 Ft. from W. Line

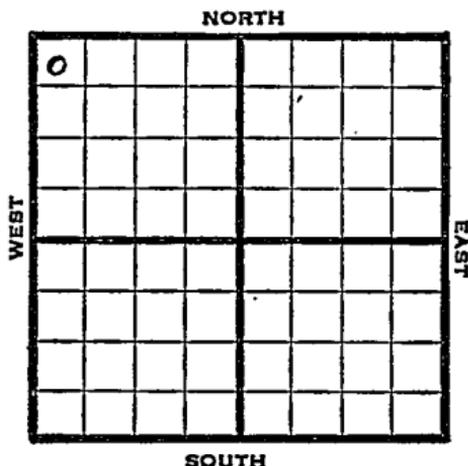

NW/4

1947 Elev. 2088' REPORT

5/14	Location
5/20	RUR
5/27	13" @ 136' anhydrite 1320' Drlg. 1635'
6/3	Lansing 3313 Drlg 3390'
6/10	Arbuckle 3618 5" @ 3622' TD 3624 RUST
6/17	Swt 31 bbls oil p/h 4hrs.
6/24	" " " " " "
7/1	" " "
7/8	" " "
7/16	Arbuckle 3618' 5" @ 3622' Depth Pot. 3000' Gr. 36 T.D. 3624' Complete

**COMPLETED**

Kansas Burnett

Map No. 71 Sec. 25 Twp. 11 R. 18W

Well No. 1 Marshall

Keyer Drlg. Company

FIRST REPORT Contractor

NW/C


SECTION PLAT

330 Ft. from N. Line

\_\_\_\_\_ Ft. from S. Line

\_\_\_\_\_ Ft. from E. Line

330 Ft. from W. Line

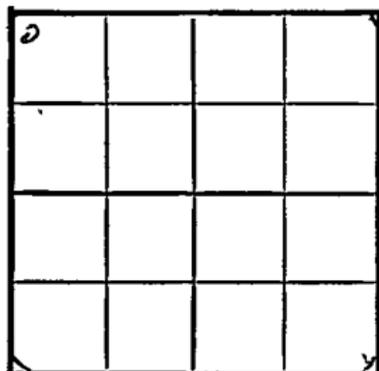

Ellis County

Location X

Rig up \_\_\_\_\_

Drilling and Remarks:

RECORD

Cased \_\_\_\_\_ in., \_\_\_\_\_ ft.

Sand \_\_\_\_\_

Gas \_\_\_\_\_

Oil \_\_\_\_\_

Total Depth 25

PRODUCTION

1st 24 hrs. Nat. \_\_\_\_\_

1st 24 hrs. after shot \_\_\_\_\_

Gas \_\_\_\_\_ Cu. Ft.

Dry Hole \_\_\_\_\_

Abandoned \_\_\_\_\_

Date

MAY 14 1947 19

S. J. LEWIS Scout

Map No. 71 Sec. 25 Twp. 11 R. 18W

Well No. 1 Marshall

Keyes Drlg. Company

**COMPLETE** Contractor

NW/C

*E 12088*  
SECTION PLAT

330 Ft. from N. Line

\_\_\_\_\_ Ft. from S. Line

\_\_\_\_\_ Ft. from E. Line

330 Ft. from W. Line

6			

Ellis County

Location \_\_\_\_\_

Rig up \_\_\_\_\_

Drilling and Remarks:

*Q 83615*  
*8" @ 3622*  
*Dep't to 3000*

*360 Gr.*

RECORD

Cased \_\_\_\_\_ in., \_\_\_\_\_ ft.

Sand \_\_\_\_\_

Gas \_\_\_\_\_

Oil \_\_\_\_\_

Total Depth 3624

PRODUCTION

1st 24 hrs. Nat. \_\_\_\_\_

1st 24 hrs. after shot \_\_\_\_\_

Gas \_\_\_\_\_ Cu. Ft.

Dry Hole \_\_\_\_\_

Abandoned \_\_\_\_\_

Date

JUL 16 1947 19 \_\_\_\_\_ S. J. LEWIS Scout