Ellis

KANSAS


FORM 51 IOM 12-46 PETROL

Section 25 Township 11 Range 18W

Well No. 2 Marshall 15-051-05212

Company Keyes Drlg.

NW NE NW

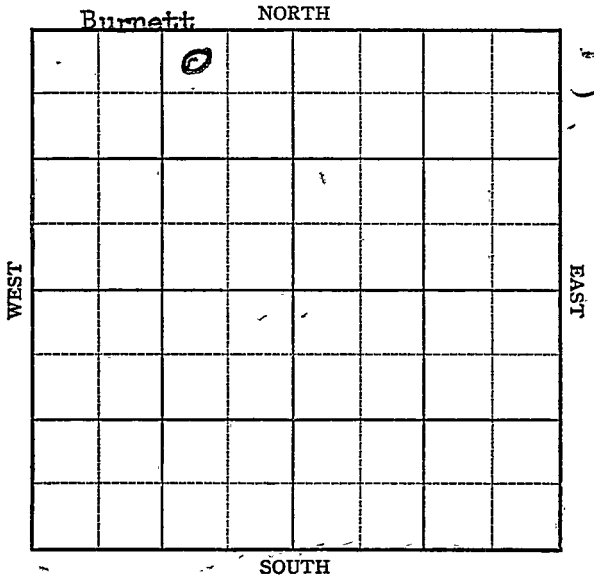

FORM 252-A
5M 12-46 PETROL

KANSAS Ellis

Sec. 25 Twp. 11 R. 18W

Well No. #2 Marshall Farm

Keyes Drlg. Company

Burnett


330 Ft. from N. Line

Ft. from S. Line

990 Ft. from E. Line

Ft. from W. Line

NW NE NW

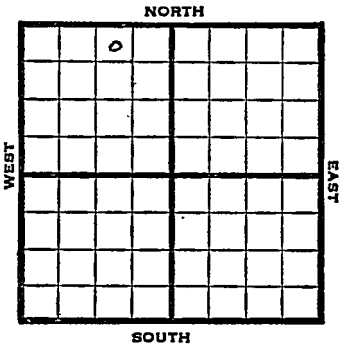

1947	Elev. 1931' REPORT
8/6	Location
8/13	Drlg. 615'
8/20	8" @ 1195' Drlg. 2450'
8/27	Lansing 8156' Arbuckle 3471' TD 3474 5" @ 3471' RUST
9/3	Swb 23 bbls. oil PH 4 hrs.
9/10	Arb. 3471' 5" @ 3471' Echo Pot. 2963' 36.0 Gr. TD 3474'

COMPLETED

Form 26 200 Bks. 10-46 Petrol

Kansas

Burnett Pool

Map No. 71 Sec. 25 Twp. 11 R. 18W

Well No. 2 Marshall


Keyes Drlg. Company

COMPLETE Contractor

NW NE NW

Feb 1, 1981

SECTION PLAT

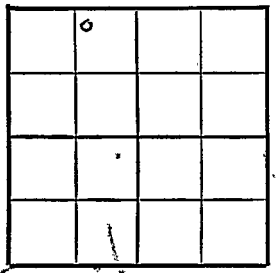

330 Ft. from N. Line

Ft. from S. Line

990 Ft. from E. Line

Ft. from W. Line

Ellis County

Location

Rig up

Drilling and Remarks:

Ark 3471

3-10 @ 3471

Ecl Lm 2968

36 ° Gr

RECORD

Cased in., ft.

Sand

Gas

Oil

Total Depth 3474

PRODUCTION

1st 24 hrs. Nat.

1st 24 hrs. after shot

Gas Cu. Ft.

Dry Hole

Abandoned

Date

SEP 10 1947 19

S. J. LEWIS Scout

Form 26 200 Bks. 10-46 Petrol

Kansas Burnett

Map No. ____ Sec. 25 Twp. 11 R. 18W


Well No. 2 Marshall

Keyes Drlg. Company

FIRST REPORT Contractor

NW NE NW

SECTION PLAT

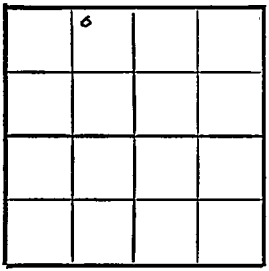

330 Ft. from N. Line

____ Ft. from S. Line

990 Ft. from E. Line

____ Ft. from W. Line

Ellis County

Location x

Rig up

Drilling and Remarks:

RECORD

Cased ____ in., ____ ft.

Sand

Gas

Oil

Total Depth

PRODUCTION

1st 24 hrs. Nat.

1st 24 hrs. after shot

Gas ____ Cu. Ft.

Dry Hole

Abandoned

Date

AUG 6 1947 19 S. J. LEWIS Scout