


Section 25 Township 11 Range 18W

Well No. #6 Marshall

Company Keyes etal.

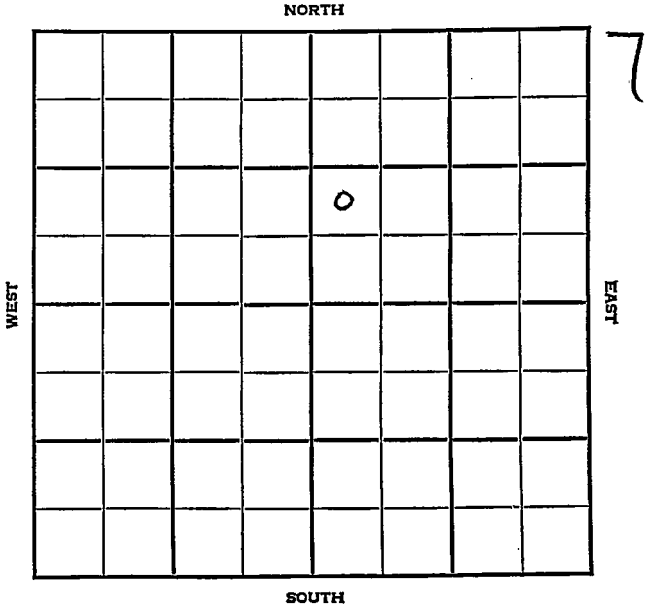

KANSAS

Ellis

Sec. 25 Twp. 11 R. 18W

Well No. #6 Marshall Farm

Keyes et al Company

Burnett Pool


Ft. from N. Line

990' Ft. from S. Line

Ft. from E. Line

330' Ft. from W. Line

NW SW NE

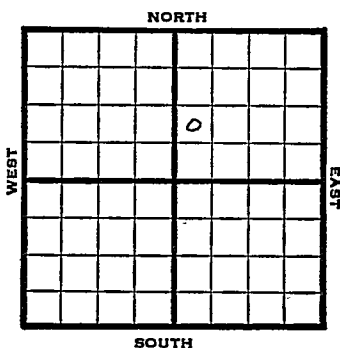

1948 Elev 1911' REPORT

5/12 RUR

5/19 8" @ 1173'  
Drlg. 2520'

5/26 Arbuckle 3450'  
TD 3454'  
5" @ 3450'  
RUST

6/1 "

6/9 TD 3459'  
swb 17 bbls oil PH 4 hrs.

6/16 500 Acid  
Flow 60 Oil 1 hr.

6/23 TD 3459'  
Arb. 3450'  
5" @ 3450' 500 acid  
Depth Pot 1428 Oil  
36° Gr.  
Comp.

COMPLETED

Map No. \_\_\_\_\_ Sec. 25 Twp. 11 R. 18W

Well No. 6 Marshall

Keyes et al. Company

**FIRST REPORT**

Contractor

NW SW NE

SECTION PLAT

\_\_\_\_\_ Ft. from N. Line

990 Ft. from S. Line

\_\_\_\_\_ Ft. from E. Line

330 Ft. from W. Line

		o	

Ellis County

Location \_\_\_\_\_

Rig up \_\_\_\_\_

Drilling and Remarks:

R U R

RECORD

Cased \_\_\_\_\_ in., \_\_\_\_\_ ft.

Sand \_\_\_\_\_

Gas \_\_\_\_\_

Oil \_\_\_\_\_

Total Depth \_\_\_\_\_

PRODUCTION

1st 24 hrs. Nat. \_\_\_\_\_

1st 24 hrs. after shot \_\_\_\_\_

Gas \_\_\_\_\_ Cu. Ft.

Dry-Hole \_\_\_\_\_

Abandoned \_\_\_\_\_

Date

MAY 12 1948 19 \_\_\_\_\_

S. J. LEWIS Scout

