


Section 25 Township 11N Range 18W

Well No. #7 Marshall

Company Keyes etal

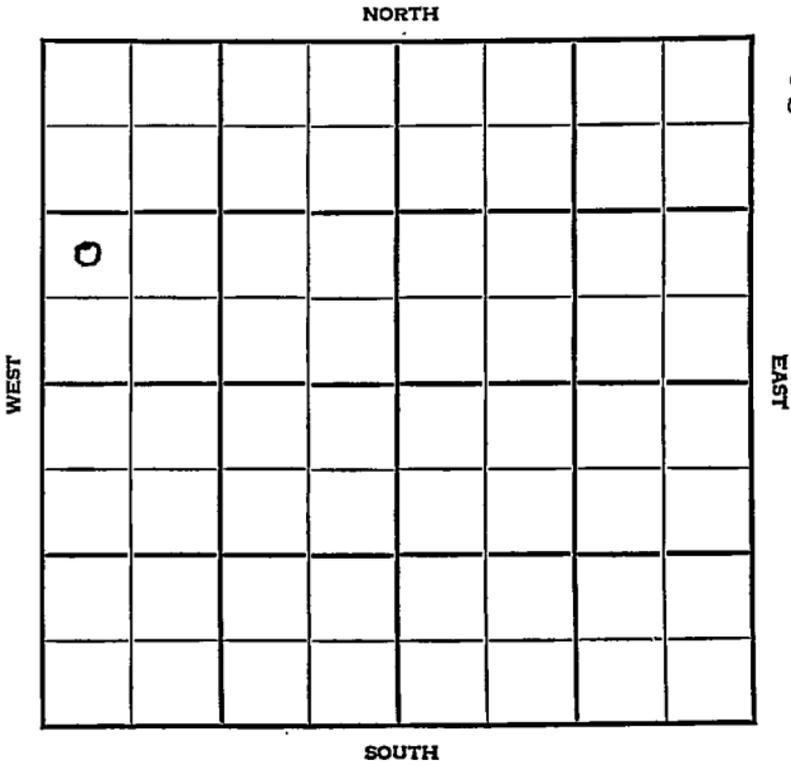

KANSAS

Ellis

Sec. 25 Twp. 11 R. 18W

Well No. #7 Marshall Farm

Keyes et al Company
Burnett Pool


_____ Ft. from N. Line

990' Ft. from S. Line

_____ Ft. from E. Line

330' Ft. from W. Line

^N
NW SW NW

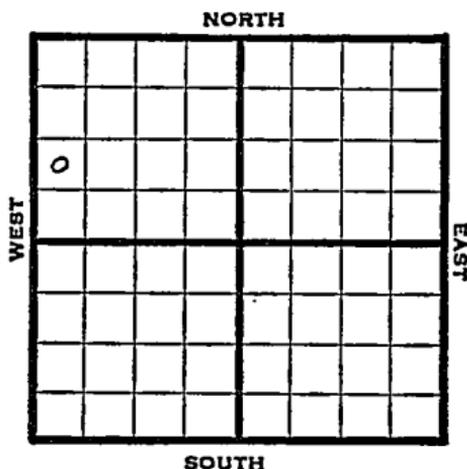

1948

Eli 1952'

REPORT

6/9

Anhy. 1216'
8" @ 1220'
Drlg. 2135'

6/16

Lansing 3195'
Simpson 3479'
Arbuckle 3501'
TD 3503'
5" @ 3501'
RUST

6/23

"'

6/29

TD 3504'
Swb 19 bbls oil PH 5 hrs.
500 acid

7/14

TD 3504'
Arb. 3501'
5"@ 3501' 500 acid
Depth Pot 1857' Oil
38° Gr.

Comp.
COMPLETED

Map No. _____ Sec. 25 Twp. 11 R. 18W

Well No. 7 Marshall

_____ Keyes et al. _____ Company

_____ **FIRST REPORT** _____ Contractor

NW SW NW

SECTION PLAT

o			

_____ Ft. from N. Line

990 Ft. from S. Line

_____ Ft. from E. Line

330 Ft. from W. Line

Ellis County

Location _____

Rig up _____

Drilling and Remarks:

Anhy 1216

8" @ 1220

drlg. 2135

RECORD

Cased _____ in., _____ ft.

Sand _____

Gas _____

Oil _____

Total Depth _____

PRODUCTION

1st 24 hrs. Nat. _____

1st 24 hrs. after shot _____

Gas _____ Cu. Ft.

Dry Hole _____

Abandoned _____

Date

JUN 9 1948

19

S. J. LEWIS

Scout

Map No. 71 Sec. 25 Twp. 11 R. 18W

Well No. 7 Marshall
Keyes et al. Company

COMPLETE

Contractor

NW SW NW

E. 11952
SECTION PLAT

o			

_____ Ft. from N. Line

990 Ft. from S. Line

_____ Ft. from E. Line

330 Ft. from W. Line

Ellis County

Location _____

Rig up _____

Drilling and Remarks:

Core 3501
5" core 3501
5000000
Dep 7/18/48
1837 oil

38' oil

RECORD

Cased _____ in., _____ ft.

Sand _____

Gas _____

Oil

Total Depth 3504

PRODUCTION

1st 24 hrs. Nat. _____

1st 24 hrs. after shot _____

Gas _____ Cu. Ft.

Dry Hole _____

Abandoned _____

Date

JUL 14 1948

S. J. LEWIS Scout