

Ellis

FORM 51

KANSAS

Section 25 Township 11 Range 19W

Well No. #1 Richards "B"

Company Jones, Shelburne & Farmer

NORTH

	0						
WEST							EAST

SOUTH

# Ellis KANSAS

SEC. <b>25</b>	TWP. <b>11</b>	R. <b>19 W</b>
-------------------	-------------------	-------------------




WELL NO. **# 1 Richards "B"** FARM

COMPANY **Jones, Shelburne & Farmer**

CONTRACTOR

**Solomon Pool**  
**330** Ft. from N. Line  
 \_\_\_\_\_ Ft. from S. Line  
 \_\_\_\_\_ Ft. from E. Line  
**330** Ft. from W. Line  
 NW NW NW

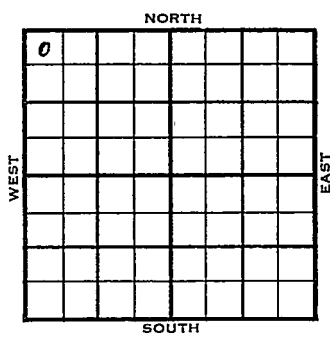

1954	ELEVATION <b>2059'</b>	REPORT
------	---------------------------	--------

<p>3/17</p> <p>3/24</p> <p>3/31</p>	<p>Spud 3-14-54          8" @ 155          Drlg. 1435'</p> <p>SD repairs</p> <p>Spud 3-14-54          D &amp; A          TD 3626'          8" @ 155'          Heeb 3277'; Tor 3296'; Lans 3319'          B KC 3546'; Simp 3595'; Arb 3616'          TD 3626'          D &amp; A</p>
-------------------------------------	---

ABANDONED

County **Ellis** State **Kansas**

Sec. **25** (Blk. Twp.) **11** (Sur. Rge.) **19W** Map No.

Operator **Jones, Shelburne & Farmer**

Well No. **1** Farm **Richards "B"**

Elev. Location **NW NW NW**

0				

**330** Ft. From **N** Line **NW**

**330** Ft. From **W** Line **Quarter**

1st. Report **MAR 17 1954**

Completion

Remarks

Spudding Date **3-14-54**

Drlg. Data **Solomon Pool**

**8" @ 155 drlg. 1435**

County Ellis State Kansas

Sec. 25 (Blk. 11 (Sur. 19W Map No. (Twp.) (Rge.)

Operator Jones, Shelburne & Farmer

Well No. 1 Farm Richards "B"

Elev. 2059 Location NW NW NW

0					

330 Ft. From N Line NW

330 Ft. From W Line Quarter

1st. Report

Completion MAR 31 1954

Remarks Solomon Pool

Spudding Date 3-14-54

Drlg. Data D & A TD 3626

8" @ 155 Heeb. 3277 Tor. 3296

Lans. 3319 B KC 3546 Simp. 3595

Arb. 3616 TD 3626

D & A