

Section 25 Township 11 Range 17-W

Well No. #20 Calahan "B"

Company Cities Service

NORTH

			0				

3

WEST

EAST

SOUTH

Sec. 25 Twp. 11 R. 17-W ✓

Well No. #20 Calahan "B" Farm

Cities Service Company

Contractor

**Bemis**


990 Ft. from N. Line

\_\_\_\_\_ Ft. from S. Line

330 Ft. from E. Line

\_\_\_\_\_ Ft. from W. Line

SE NE NW

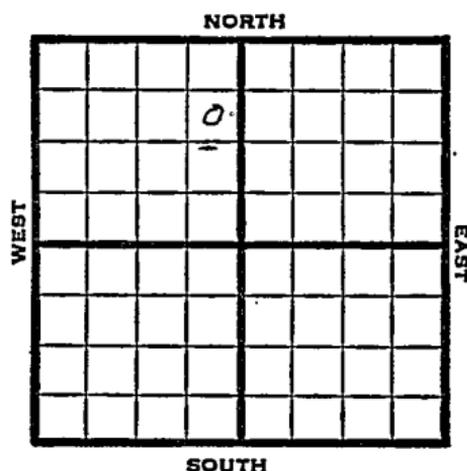

1950 Elev. 1959' REPORT

10/4 Location

12/27 Oil Well TD 3520  
8" @ 1156  
Heeb. 3120 Dodge 3140  
Lans. 3171 Simp. 3439  
Arb. 3453  
TD 3520 5" @ 3520  
17/3496-99 FU 315' oil 100' wtr  
13 hr.  
250 A P/68 bo 22 bw 16 hr  
Comp. 44 bopd 41% wtr.

**COMPLETED**

County **Ellis** State **Kansas**

Sec. **25** (Blk. Twp.) **11** (Sur. Rge.) **17W** Map No.

Operator **Cities Service**

Well No. **20** Farm **Calahan "B"**

Elev. \_\_\_\_\_ Location **SE NE NW**

		o			

**990** Ft. From **N** Line **NW**

**330** Ft. From **E** Line **Quarter**

1st. Report **OCT 4 1950**

Completion \_\_\_\_\_

Remarks \_\_\_\_\_

Spudding Date \_\_\_\_\_

Drlg. Data **Bemis Pool**

**Location**

J. E. TYRA

