

Trego

DX 78-1

Section 25 Township 11 Range 21W

Well No. #1 Walter Huck

Company Stanolind.

NORTH

6							

4

WEST

EAST

SOUTH

Trego

KANSAS


SEC.	TWP.	R.
25	11	21 W

WELL NO. # 1 Walter Huck FARM
 COMPANY

CONTRACTOR Stanolind

Iron Drlg.
 S. Walz Pool

990 Ft. from N. Line
 _____ Ft. from S. Line
 _____ Ft. from E. Line
 330 Ft. from W. Line

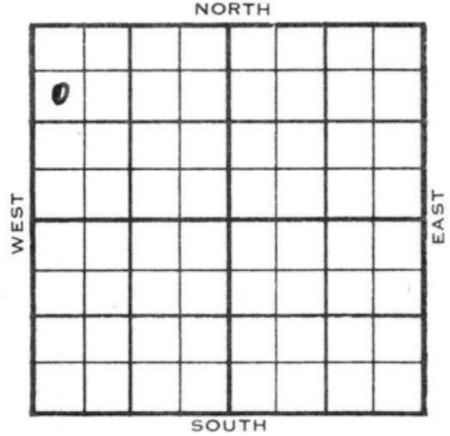

SW NW NW

	ELEVATION	REPORT
1955	2248'	

2/16 Spud 2-13-55
 8" @ 198
 Drlg. 238'
 3/2 Spud 2-13-55
 D & A
 TD 3899'
 8" @ 198'
 Heeb 3494', Lans 3532' Arb. 3835'
 DST 3830'-38' opn 45 min, rec 20' drlg.
 mud, 40#
 TD 3899'
 D& A

ABANDONED


County **Trego** State **Kansas**

Sec. **25** (Blk.) **11** (Sur.) **21W** Map No.

Operator **Stanolind**

Well No. **1** Farm **Walter Huck**

Elev. Location **SW NW NW**

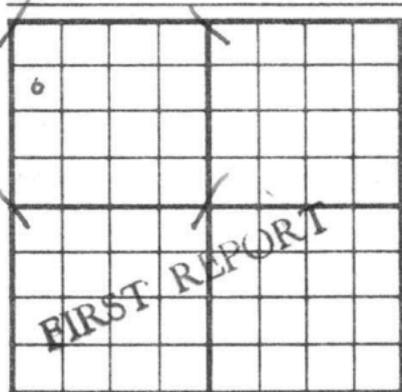

990 Ft. From **N** Line **NW**

330 Ft. From **W** Line Quarter

Ist. Report **FEB 16 1955**

Completion

Remarks

Iron Drlg. - Contr.

Spudding Date **2-13-55**

Drlg. Data **S. Walz Pool**

8" @ 198 drlg. 238

FABEN GILSTRAP

County **Trego** State **Kansas**

Sec. **25** (Blk. **11**) (Sur. Rge.) **21W** Map No.

Operator **Stanolind**

Well No. **1** Farm **Walter Huck**

Elev. **2248** Location **SW NW NW**

990 Ft. From **N** Line **NW**

330 Ft. From **W** Line **Quarter**

Ist. Report

Completion **MAR 2 1955**

Remarks **S. Walz Pool**

Iron Drlg. - Contr.

Spudding Date **2-13-55**

Drlg. Data **D & A** **TD 3899**

8" @ 198 Heeb. 3494 Lans. 3532

Arb. 3835 DST 3830-38 open 45 min.

Rec. 20' drlg. mud 40# TD 3899

D & A

FABEN GILSTRAP