

Ellis


FORM 51 5M 4-41 PETROL

KANSAS

Section 25 Township 11 Range 17W

Well No. 7 Colahan B

Company Cities Service Oil

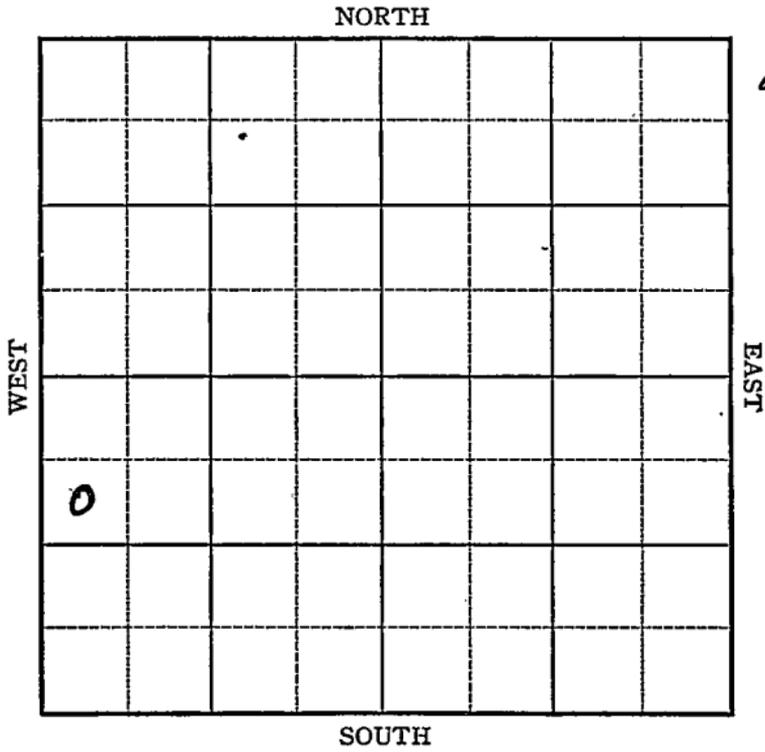

Sec. 25 Twp. 11 R. 17-W

Well No. #7 Colahan "B" Farm

Cities Service Oil Company

(Bemis)


950 Ft. from N. Line

         Ft. from S. Line

         Ft. from E. Line

330 Ft. from W. Line

Elev. 2003

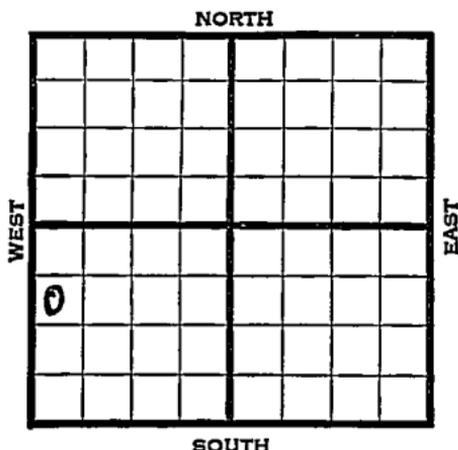

| 1941 | REPORT   |
|------|--|
| 7/16 | Derrick.   |
| 7/24 | 8" @ 348 drlg. 1990                                |
| 7/31 | Drlg. 3043'  |
| 8/7  | Arb 3477' 5" @ 3478' TD 3504'<br>2800' oil 14 hrs. |
| 8/13 | Arb. 3477'   |
|      | 5" - 3478'   |
|      | 2000 acid  |
|      | T.D..3516'   |
|      | Echo. Pot. 7658' - no water                        |
|      | Grav. 33.5   |
|      |  |
|      |  |
|      |  |
|      |  |
|      |  |
|      |  |
|      |  |
|      |  |
|      |  |

Map No. 71 Sec. 25 Twp. 11 R. 17WWell No. 7 Colahan "B"Cities Service Oil Company

Contractor

**FIRST REPORT**

SW NW SW

950 Ft. from N. Line

\_\_\_\_\_ Ft. from S. Line

\_\_\_\_\_ Ft. from E. Line

330 Ft. from W. Line**SECTION PLAT**

|   |  |  |  |
|---|--|--|--|
|   |  |  |  |
|   |  |  |  |
|   |  |  |  |
| o |  |  |  |
|   |  |  |  |

**BEMIS POOL**

Location \_\_\_\_\_

Rig up \_\_\_\_\_

Drilling and Remarks:

Derrick

**RECORD**

Cased \_\_\_\_\_ in., \_\_\_\_\_ ft.

Sand \_\_\_\_\_

Gas \_\_\_\_\_

Oil \_\_\_\_\_

Total Depth \_\_\_\_\_

**PRODUCTION**

1st 24 hrs. Nat. \_\_\_\_\_

1st 24 hrs. after shot \_\_\_\_\_

Gas \_\_\_\_\_ Cu. Ft.

Dry Hole \_\_\_\_\_

Abandoned \_\_\_\_\_

Date

JUL 16 1941 19 \_\_\_\_\_ S. J. LEWIS Scout

Map No. 71 Sec. 25 Twp. 11 R. 17WWell No. 7 Colahan "B"Cities Service Oil Company

Contractor

## SECTION PLAT

SW NW SW  
950 Ft. from N. Line

\_\_\_\_\_ Ft. from S. Line

\_\_\_\_\_ Ft. from E. Line

330 Ft. from W. Line

|  |  |  |  |
|--|--|--|--|
|  |  |  |  |
|  |  |  |  |
|  |  |  |  |
|  |  |  |  |
|  |  |  |  |

BEMIS POOL

Location \_\_\_\_\_

Rig up \_\_\_\_\_

Drilling and Remarks:

*arb 3477*  
*5" 3478*  
*2000 acid*  
*Echo Pot. 7658*  
*no wat*  
**COMPLETED**

## RECORD

Cased \_\_\_\_\_ in., \_\_\_\_\_ ft.

Sand \_\_\_\_\_

Gas \_\_\_\_\_

Oil \_\_\_\_\_

Total Depth 3516

## PRODUCTION

1st 24 hrs. Nat. \_\_\_\_\_

1st 24 hrs. after shot \_\_\_\_\_

Gas \_\_\_\_\_ Cu. Ft.

Dry Hole \_\_\_\_\_

Abandoned \_\_\_\_\_

Date

*335 gas*

AUG 13 1941

19

S. J. LEWIS Scout