

KANSAS


FORM 51 5M 10-41 PETROL

Ellis

Section 25 Township 11 Range 17-W

Well No. 11 Colahan "B"

Company Cities Service Oil

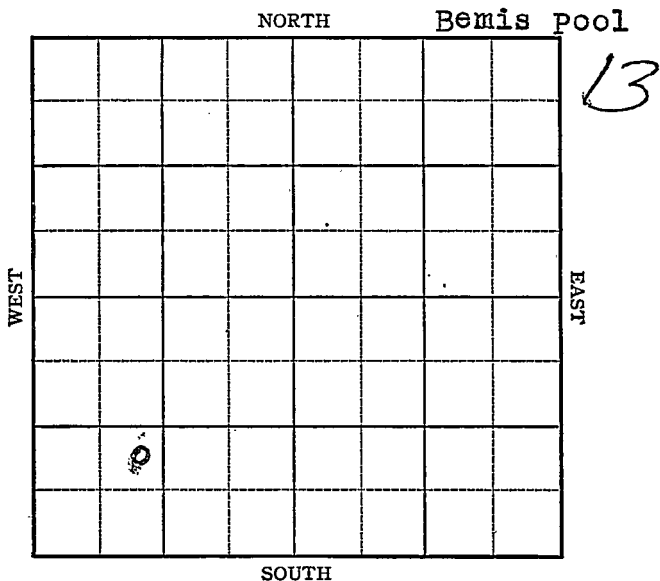

1942

2/4

Lans. 3247'

5" - 3519'

Arb. 3517'

T.D. 3575'

P.B. to 3560'

Shot 10 qts. 3524-30'

3000 acid.

Potential 451 bbls., pump.

34.6 Gravity

COMPLETED

Ellis

KANSAS

Map No. 7/ Sec. 25 Twp. 11 R. 17WWell No. 11 Colahan "B"

Cities Service Oil

Company

FIRST REPORT

Contractor

NE SW SW

2 Ft. from N. Line990 Ft. from S. Line

_____ Ft. from E. Line

1030 Ft. from W. Line

SECTION PLAT

BEMIS POOL

Location XX

Rig up _____

Drilling and Remarks:

RECORD

Cased _____ in., _____ ft.

Sand _____

Gas _____

Oil _____

Total Depth _____

PRODUCTION

1st 24 hrs. Nat. _____

1st 24 hrs. after shot _____

Gas _____ Cu. Ft.

Dry Hole _____

Abandoned _____

Date

DEC 3 1941S. I. LEWIS Scout

Misc. Small Maps	<i>DAS</i>
Cards	<i>DAS</i>
Tracing	<i>DAS</i>
France Map	<i>DAS</i>
Scarborough Map	<i>DAS</i>
Moody Map	<i>DAS</i>
Geological Dept.	
Moody Plat Book	

Map No. 71 Sec. 25 Twp. 11 R. 17W

Well No. 11 Colahan "B"

Cities Service Oil Company

COMPLETED

Contractor

NE SW SW

SECTION PLAT

_____ Ft. from N. Line

990 Ft. from S. Line

_____ Ft. from E. Line

1030 Ft. from W. Line

BEMIS POOL

RECORD

Location _____

Cased _____ in., _____ ft.

Rig up _____

Sand _____

Drilling and Remarks:

Gas _____

Lease 3247

Oil _____

Total Depth 3525

5" @ 3519

Per 3517

P.B. 3560

109 to 3524-30

3000 cu ft

Pump 451 Prod.

346 Gr

PRODUCTION

1st 24 hrs. Nat. _____

1st 24 hrs. after shot _____

Gas _____ Cu. Ft.

Dry Hole _____

Abandoned _____

Date

FEB 4 1942

19

S. J. LEWIS

Scout

Misc. Small Maps	<i>W</i>
Cards	<i>W</i>
Tracing	<i>W</i>
France Map	<i>W</i>
Scarborough Map	<i>W</i>
Moody Map	<i>W</i>
Geological Dept.	
Moody Flat Book	