

Ellis


FORM 51 5M 4-41 PETROL

KANSAS

Section 25 Township 11 Range 17W

Well No. #8 Colahan B

Company Cities Service Oil

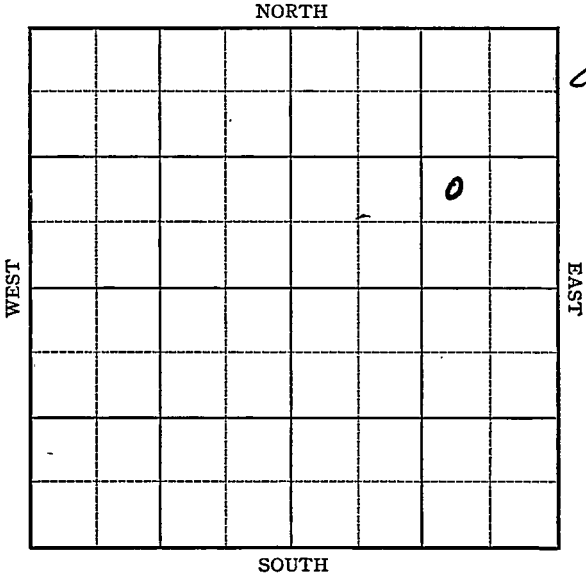

Sec. 25 Twp. 11 R. 17-W

Well No. #8 Colahan "B" Farm

Cities Service Oil Company

(Bemis)


\_\_\_\_\_ Ft. from N. Line

990 Ft. from S. Line

990 Ft. from E. Line

\_\_\_\_\_ Ft. from W. Line

Elev. 1877

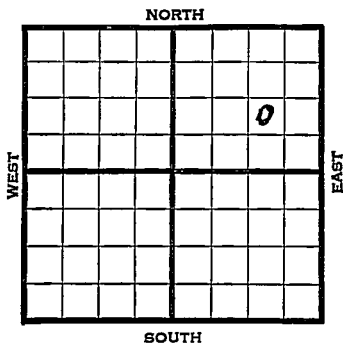

194	REPORT
7/16	Location
7/24	Surface hole
7/31	8" @ 1059
	Drl g. 2300
8/7	Drl g. 3252'
8/15	Lans. 3088 Simpson 3354
	Arb. 3356 5" @ 3357'
	T.D. 3378
	1900' oil 12 hrs
	RUST
8/20	Arb. 3356'
	5" - 3357'
	T.D. 3378'
	2000 acid.
	Potential 289 bbls., pump.
	33.5 Gravity
	<b>COMPLETED</b>

Map No. 71 Sec. 25 Twp. 11 R. 17WWell No. 8 Colahan "B"Cities Service Oil Company

Contractor

**FIRST REPORT**

NW SE NE

\_\_\_\_\_ Ft. from N. Line

990 Ft. from S. Line990 Ft. from E. Line

\_\_\_\_\_ Ft. from W. Line

**SECTION PLAT**

			o

**BEMIS POOL**Location X

Rig up \_\_\_\_\_

Drilling and Remarks: \_\_\_\_\_

**RECORD**

Cased \_\_\_\_\_ in., \_\_\_\_\_ ft.

Sand \_\_\_\_\_

Gas \_\_\_\_\_

Oil \_\_\_\_\_

Total Depth \_\_\_\_\_

**PRODUCTION**

1st 24 hrs. Nat. \_\_\_\_\_

1st 24 hrs. after shot \_\_\_\_\_

Gas \_\_\_\_\_ Cu. Ft.

Dry Hole \_\_\_\_\_

Abandoned \_\_\_\_\_

Date

JUL 16 1941 19S. J. LEWIS Scout

Map No. 71 Sec. 25 Twp. 11 R. 17WWell No. 8 Colahan "B"Cities Service Oil Company

Contractor

**COMPLETED**

NW SE NE

\_\_\_\_\_ Ft. from N. Line

990 Ft. from S. Line990 Ft. from E. Line

\_\_\_\_\_ Ft. from W. Line

## SECTION PLAT

			0

BEMIS POOL

Location \_\_\_\_\_

Rig up \_\_\_\_\_

Drilling and Remarks:

*CR 8 3356**5" @ 3357**2000cciol**Pump. 289 Rd.**335 82*

## RECORD

Cased \_\_\_\_\_ in., \_\_\_\_\_ ft.

Sand \_\_\_\_\_

Gas \_\_\_\_\_

Oil \_\_\_\_\_

Total Depth 3378

## PRODUCTION

1st 24 hrs. Nat. \_\_\_\_\_

1st 24 hrs. after shot \_\_\_\_\_

Gas \_\_\_\_\_ Cu. Ft.

Dry Hole \_\_\_\_\_

Abandoned \_\_\_\_\_

Date

AUG 20 1941 19S. J. LEWIS Scout