

# KANSAS

Ellis

FORM 51 5M 4-41 PETROL

Section 25 Township 11 Range 17W

Well No. #6 Colahan "B"

Company Cities Service Oil

|  |  |  |   |  |  |  |  |
|--|--|--|---|--|--|--|--|
|  |  |  | 0 |  |  |  |  |
|  |  |  |   |  |  |  |  |
|  |  |  |   |  |  |  |  |
NORTH

SOUTH

WEST

EAST

3

KANSAS


Ellis

Sec. 25 Twp. 11 R. 17-WWell No. #6 Coleman "B" FarmCities Service Oil Company

(Bemis)

330 Ft. from N. Line       Ft. from S. Line330 Ft. from E. Line       Ft. from W. Line

Elev. 1940

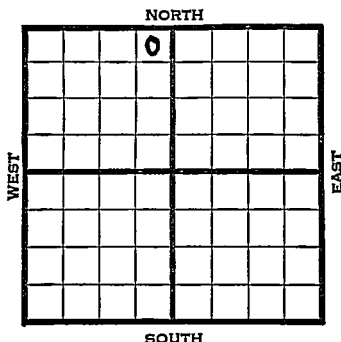

1941

REPORT

7/1 Mov. in Mat'l.

7/10 8" - 1070' Drlg. 2280'

7/17 Arb. 3405-08' T.D. 5" - 3406'  
RUST.7/24 TD 3416 2300' oil 8½ hrs.  
1000 acid.

7/31 TD 3424' 2000 acid. Testing.

8/6 Arb 3405'  
5" @ 3406'

TD 3424'

3000 acid

Echo Potential 16751

Max, 3000

Gravity 33.5

~~COMPLETED~~

Map No. 71 Sec. 25 Twp. 11 R. 17WWell No. 6 Colahan "B"

Cities Service Oil

Company

FIRST REPORT

Contractor

NE NW

330 Ft. from N. Line       Ft. from S. Line330 Ft. from E. Line       Ft. from W. Line

BEMIS POOL

## SECTION PLAT

|  |  |  |  |
|--|--|--|--|
|  |  |  |  |
|  |  |  |  |
|  |  |  |  |
|  |  |  |  |
|  |  |  |  |

Location                                 Rig up                                 

Drilling and Remarks:

Mov. in Matle

## RECORD

Cased            in.,            ft.Sand                                 Gas                                 Oil                                 Total Depth                                 

## PRODUCTION

1st 24 hrs. Nat.                                 1st 24 hrs. after shot                                 Gas                                  Cu. Ft.Dry Hole                                 Abandoned                                 

Date

JUL 1 1941 19 S. I. LEWIS Scout

Map No. \_\_\_\_\_ Sec. 25 Twp. 11 R. 17W

Well No. 6 Colahan "B"

Cities Service Oil

Company

COMPLETER

Contractor

NE NW

## SECTION PLAT

|  |  |   |  |
|--|--|---|--|
|  |  | 0 |  |
|  |  |   |  |
|  |  |   |  |
|  |  |   |  |

330 Ft. from N. Line

\_\_\_\_\_ Ft. from S. Line

330 Ft. from E. Line

\_\_\_\_\_ Ft. from W. Line

BEMIS POOL

Location \_\_\_\_\_

## RECORD

Cased \_\_\_\_\_ in., \_\_\_\_\_ ft.

Sand \_\_\_\_\_

Gas \_\_\_\_\_

Oil \_\_\_\_\_

Total Depth, 3424

Rig up \_\_\_\_\_

Drilling and Remarks:

Cn 8405

5" @ 3406

3000 Acid

Echo R 16751

Max 3000

335 G

## PRODUCTION

1st 24 hrs. Nat. \_\_\_\_\_

1st 24 hrs. after shot \_\_\_\_\_

Gas \_\_\_\_\_ Cu. Ft.

Dry Hole \_\_\_\_\_

Abandoned \_\_\_\_\_

Date

AUG 6 1941 19

S. J. LEWIS

Scout