

KANSAS

Elis


Form 51-5M-7-39-Palace

Section 25 Township 11 Range 17W

Well No. #1 Colahan "B"

Company Cities Cities Oil

NORTH

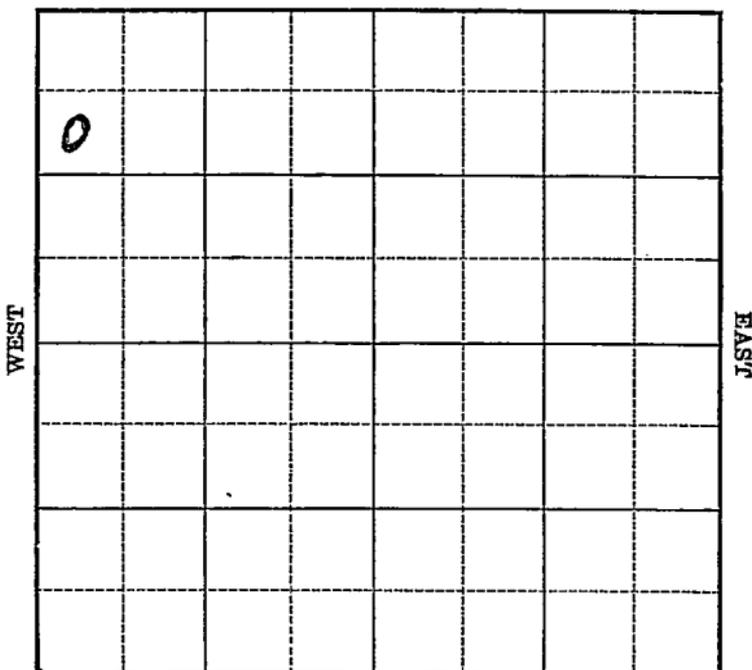

SOUTH

WEST

EAST

Sec. 25 Twp. 11 R. 17-W

Well No. #1 Colahan "B" Farm

Cities Service Oil Company

(Bemis)


990 Ft. from N. Line

Ft. from S. Line

Ft. from E. Line

330 Ft. from W. Line

Elev. 2079

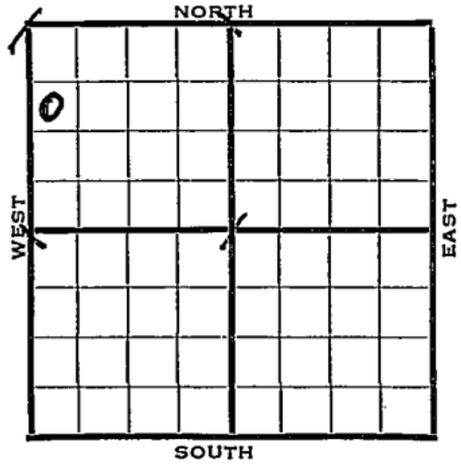

1940	REPORT
7/17	Location
7/25	Drlg. 1010'
8/2	8" - 1110' Drlg. 2103'
8/8	Drlg. 3016'
8/14	Arb. 3554-50 ³⁵⁵⁵ T.D.
	5" @ 3555- R.U.S.T.
8/22	Arb. 3555' (Corrected)
	5" - 3555' T.D. 3570'
	2600' oil 5 hrs. 500 acid.
8/29	2000 acid. No help.
	T.D. 3600' 4000 acid. Testing.
9/4	Arb. 3555'
	5" - 3555'
	T.D. 3600'
	6000 acid.
	Echometer potential 2420 bbls.
COMPLETED	

Map No. _____ Sec. 25 Twp. 11 R. 17W

Well No. 1 Colahan "B"

Cities Service Oil Company

Contractor

FIRST REPORT

SW NW NW

990' Ft. from N. Line

_____ Ft. from S. Line

_____ Ft. from E. Line

330' Ft. from W. Line

BEMIS POOL

SECTION PLAT

Location X

Rig up _____

Drilling and Remarks: _____

RECORD

Cased _____ in., _____ ft.

Sand _____

Gas _____

Oil _____

Total Depth _____

PRODUCTION

1st 24 hrs. Nat. _____

1st 24 hrs. after shot _____

Gas _____ Cu. Ft.

Dry Hole _____

Abandoned _____

Date

JUL 17 1940 19

S. J. LEWIS Scout

Map No. _____ Sec. 25 Twp. 11 R. 17W

Well No. 1 Colahan "B"

Cities Service Oil Company

Contractor

COMPLETED

SW NW NW

990 Ft. from N. Line

_____ Ft. from S. Line

_____ Ft. from E. Line

330 Ft. from W. Line

BEMIS POOL

SECTION PLAT

o			
		.	

Location _____

Rig up _____

Drilling and Remarks:

Cr 83555.

5" C 3555.

6000 acid

Echometer P & S

2420

RECORD

Cased _____ in., _____ ft.

Sand _____

Gas _____

Oil _____

Total Depth *3600*

PRODUCTION

1st 24 hrs. Nat. _____

1st 24 hrs. after shot _____

Gas _____ Cu. Ft.

Dry Hole _____

Abandoned _____

Date

SEP 4 1946

S. J. LEWIS Scout