


Section 25 Township 11 Range 18-WWell No. #8 MarshallCompany Keyes Drlg.

LOC

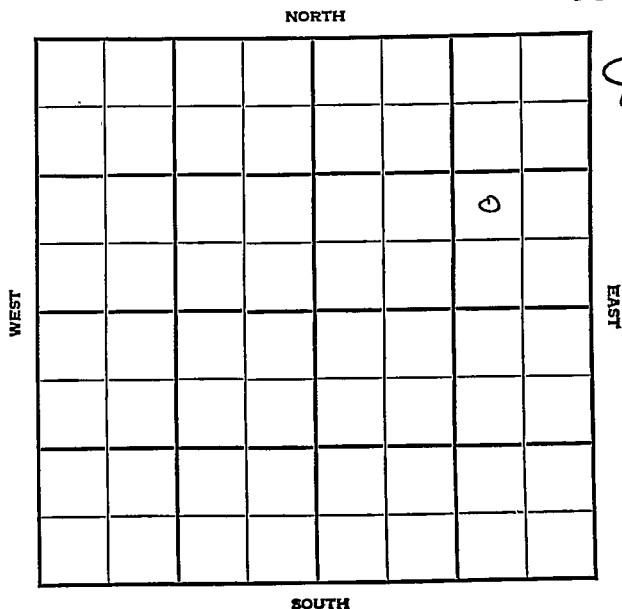

KANSAS

Ellis

Sec. 25 Twp. 11 R. 18W

Well No. #8 Marshall Farm

Keyes Drlg. Company

Burnett Pool


Ft. from N. Line

990' Ft. from S. Line

990' Ft. from E. Line

Ft. from W. Line

NW SE NE

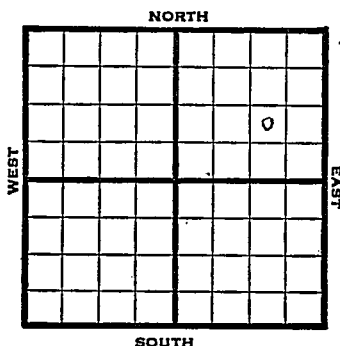

1948

REPORT

E1: 2101:

6/30

Location

7/8

"

7/14

"

7/21

"

7/28

"

8/4

Loc

Aband.

ABANDONED

Ellis County Kansas State

Map No. 71 Sec. 25 Twp. 11 R. 18W

Well No. 8 Marshall

Keyes Drlg. Company

ABANDONED Contractor

NW SE NE


E12101
SECTION PLAT

 Ft. from N. Line

990 Ft. from S. Line

990 Ft. from E. Line

 Ft. from W. Line

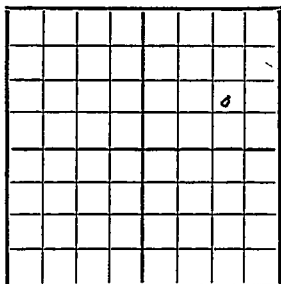

Burnett-Pool

Remarks:

Loc

Date
AUG 4 1948

Scout
S. J. LEWIS

Map No. _____ Sec. 25 Twp. 11 R. 18W

Well No. 8 Marshall

Keyes Drlg. Company

FIRST REPORT

Contractor

NW SE NE

SECTION PLAT

_____ Ft. from N. Line

990 Ft. from S. Line

990 Ft. from E. Line

_____ Ft. from W. Line

			o

Ellis County

Location X

Rig up _____

Drilling and Remarks:

RECORD

Cased _____ in., _____ ft.

Sand _____

Gas _____

Oil _____

Total Depth _____

PRODUCTION

1st 24 hrs. Nat. _____

1st 24 hrs. after shot _____

Gas _____ Cu. Ft.

Dry Hole _____

Abandoned _____

Date

JUN 30 1948 19 S. J. LEWIS Scout