
FORM CP-4

STATE OF KANSAS
STATE CORPORATION COMMISSION

State Geological Survey
WICHITA BRANCH

WELL PLUGGING RECORD

Give All Information Completely
Make Required Affidavit
Mail or Deliver Report to
Conservation Division
State Corporation Comm.
245 North Water
Wichita, KS 67202

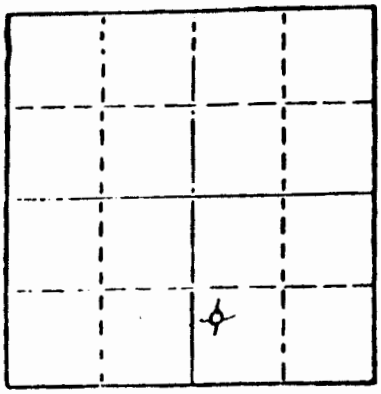

Locate well correctly on above Section Plat

Trego County. Sec. 1 Twp. 11 Rge. 25 E/W

Location as "NE/CNW¼SW¼" or footage from lines
NW SW SE

Lease Owner Helberg Oil Company

Lease Name Hobbs Well No. #4

Office Address Box 32 Morland, Kansas 67650

Character of Well (Completed as Oil, Gas or Dry Hole)
Dry Hole

Date Well completed 10-3 19 81

Application for plugging filed 10-3 19 81

Application for plugging approved 10-3 19 81

Plugging commenced 10-3 19 81

Plugging completed 10-3 19 81

Reason for abandonment of well or producing formation
Dry Hole

If a producing well is abandoned, date of last production
19

Was permission obtained from the Conservation Division or its agents before plugging was commenced? Yes

Name of Conservation Agent who supervised plugging of this well Gil Balthazor

Producing formation Depth to top Bottom Total Depth of Well 3990'

Show depth and thickness of all water, oil and gas formations.

OIL, GAS OR WATER RECORDS — CASING RECORD

FORMATION	CONTENT	FROM	TO	SIZE	PUT IN	PULLED OUT
Surface		0	209'	8 5/8"	209'	0

Describe in detail the manner in which the well was plugged, indicating where the mud fluid was placed and the method or methods used in introducing it into the hold. If cement or other plugs were used, state the character of same and depth placed, from feet to feet for each plug set.

1st. Plug set at 1050' with 70 sacks common cement 50-50poz 4%Gel 3%Cal Cl.

2nd. Plug set at 180' with 40 sacks common cement 50-50poz 4%Gel 3%Cal Cl.

3rd. Plug set at 40' with 10 sacks common cement 50-50poz 4%Gel 3%Cal Cl.

5 sacks in rathole

Heavy Drilling mud between each plug.

(If additional description is necessary, use BACK of this sheet)

Name of Plugging Contractor Sun Oilwell Cementing

STATE OF Kansas COUNTY OF Graham, ss.

Jerry M. Helberg (employee of owner) or (owner or operator) of the above-described well, being first duly sworn on oath, says: That I have knowledge of the facts, statements, and matters herein contained and the log of the above-described well is filed and that the same are true and correct. So help me God.