

STATE CORPORATION COMMISSION OF KANSAS
OIL & GAS CONSERVATION DIVISION

WELL COMPLETION OR RECOMPLETION FORM
ACO-1 WELL HISTORY

DESCRIPTION OF WELL AND LEASE

Operator: License # 4202
Name Hill Country Exploration
Address 165 S. Union Blvd., Suite 380
Lakewood, Co 80228
City/State/Zip

Purchaser

Operator Contact Person Tom Heathman
Phone 303-863-0014

Contractor: License # 5418
Name Allen Drilling Company

Wellsite Geologist Bryan Bynog
Phone (303) 642-3681

Designate Type of Completion

- New Well Re-Entry Workover
- Oil SWD Temp Abd
- Gas Inj Delayed Comp.
- Dry Other (Core, Water Supply etc)

If OWWO: old well info as follows:

Operator
Well Name
Comp. Date Old Total Depth

WELL HISTORY

Drilling Method:

- Mud Rotary Air Rotary Cable

3-22-85 3-28-85 3-29-85
Spud Date Date Reached TD Completion Date
4450
Total Depth PBTD

Amount of Surface Pipe Set and Cemented at 345 feet
Multiple Stage Cementing Collar Used? Yes No
if yes, show depth set feet
if alternate 2 completion, cement circulated
from feet depth to w/SX cmt

API NO. 15-195-21,683

County Trego

SW SE SW Sec 1 Twp 11 Rge 25 East West

330 Ft North from Southeast Corner of Section
3630 Ft West from Southeast Corner of Section

(Note: Locate well in section plat below)


Lease Name Ruth Pope Well # 1-1

Field Name Tidball

Producing Formation

Elevation: Ground 2403 KB 2408

Section Plat

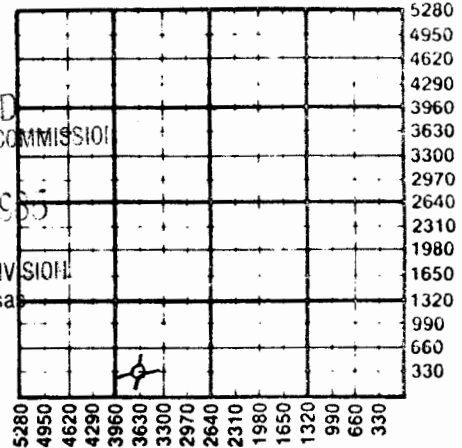

WATER SUPPLY INFORMATION

Disposition of Produced Water: Disposal Repressuring
Docket #

Questions on this portion of the ACO-1 call:
Water Resources Board (913) 296-3717

Source of Water:
Division of Water Resources Permit #

Groundwater Ft North from Southeast Corner (Well) Ft West from Southeast Corner of Sec Twp Rge East West

Surface Water 2720' Ft North from Southeast Corner (Stream, pond etc) 100' Ft West from Southeast Corner Sec 12 Twp 11S Rge 25 East West

Other (explain) (purchased from city, R.W.D. #)

INSTRUCTIONS: This form shall be completed in duplicate and filed with the Kansas Corporation Commission, 200 Colorado Derby Building, Wichita, Kansas 67202, within 90 days after completion or recompletion of any well. Rule 82-3-130 and 82-3-107 apply. Information on side two of this form will be held confidential for a period of 12 months if requested in writing and submitted with the form. See rule 82-3-107 for confidentiality in excess of 12 months. One copy of all wireline logs and drillers time log shall be attached with this form. Submit CP-4 form with all plugged wells. Submit CP-111 form with all temporarily abandoned wells.

98385

SIDE TWO

Operator Name Hill Country Exploration Lease Name Ruth Pope Well # 1

Sec 1 Twp 11 Rge 25 East West County Trego

WELL LOG

INSTRUCTIONS: Show important tops and base of formations penetrated. Detail all cores. Report all drill stem tests giving interval tested, time tool open and closed, flowing and shut-in pressures, whether shut-in pressure reached static level, hydrostatic pressures, bottom hole temperature, fluid recovery, and flow rates if gas to surface during test. Attach extra sheet if more space is needed. Attach copy of log.

Drill Stem Tests Taken [X] Yes [] No
Samples Sent to Geological Survey [] Yes [X] No
Cores Taken [] Yes [X] No

Formation Description [X] Log [] Sample

DST #1 3890'-3924' LKC "I" zone
Times: 15:30:60:90
Rec - 5' oil + 65' oil cut mud
IHP 2030 FFP 71-71
IFP 61-61 FSIP 469 BHT 109°
ISIP 448 FHP 1907

DST #2 3850'-3883' LKC "H" zone
Hook wall
Times: 15:30:60:90
Rec - 45' mud w/ spots oil
IHP 1958 FFP 51-51
IFP 51-51 FSIP 102 BHT 114°
ISIP 173 FHP 1927

Table with 3 columns: Name, Top, Bottom. Rows include Stone Corral Anhy., Lansing, Base Kansas City, Pawnee, Ft. Scott, Mississippian, Viola, Arbuckle.

CASING RECORD [X] New [] Used

Report all strings set-conductor, surface, intermediate, production, etc.

Table with 8 columns: Purpose of String, Size Hole Drilled, Size Casing Set (in O.D.), Weight Lbs/Ft., Setting Depth, Type of Cement, #Sacks Used, Type and Percent Additives. Row 1: Surface, 12 1/4, 8 5/8, 20#, 345, Regular, 200, 2% Gel 3% CC.

PERFORATION RECORD

Acid, Fracture, Shot, Cement Squeeze Record

Table with 3 columns: Shots Per Foot, Specify Footage of Each Interval Perforated, (Amount and Kind of Material Used), Depth.

TUBING RECORD Size Set At Packer at Liner Run [] Yes [] No

Date of First Production Producing Method