

Russell

DX 78-1


KANSAS

Section 26 Township 11 Range 15W

Well No. #1 Eulert

Company Jones, Shelburne & Farmer

NORTH

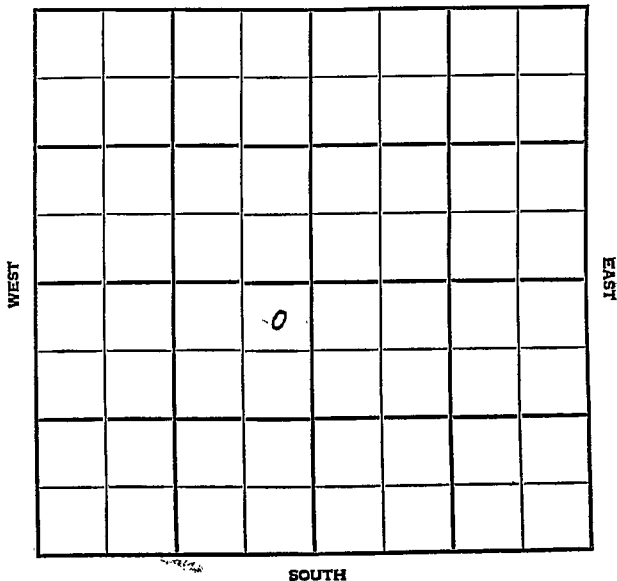

Russell

KANSAS

TWP.

R.

26

11

15 W

WELL NO.

# 1 Eulert

FARM

COMPANY

Jones, Shelburne & Farmer

CONTRACTOR

Co. tools

Wildcat


330 Ft. from N. Line

Ft. from S. Line

330 Ft. from E. Line

Ft. from W. Line

NE NE SW

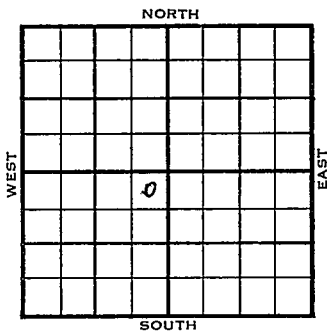

ELEVATION

REPORT

1954

1887'

12/22

Spud 12-16-54  
8" @ 175'  
Drlg. 2700'

1955  
1/5

Spud 12-16-54  
D & A  
TD 3390'  
8" @ 175'  
Heeb 2994', Tor 3015' Lans 3048'  
DST 3065'-96' opn 1 hr rec 270' s.w.  
580#  
DST 3142'-52' EroArb. 3362' Arb. 3369'  
TD 3390'  
D & A

**ABANDONED**



