

KANSAS

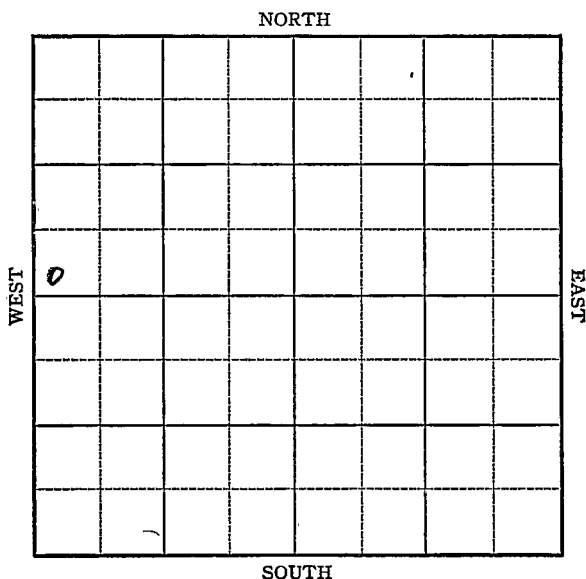
Russell

FORM 51 5M 10-41 PETROL

Section 26 Township 11 Range 15-W

Well No. #1 Eulert

Company Dickey Oil



KANSAS

Russell

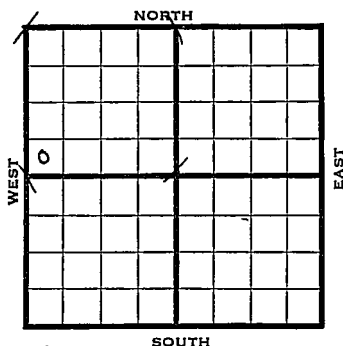
Sec. 26 Twp. 11 R. 15-WWell No. #1 Eulert FarmDickey Oil Company

Wildcat

Ft. from N. Line

330 Ft. from S. Line

Ft. from E. Line

330 Ft. from W. Line

SW NW

Elev. 1853

1942

REPORT

12/22 10" @ 620'
Anhy. 945'
Drlg. 1215'

~~12/29~~ 1943
1/6 Drlg. 2500

Dodge 2942
Lans 2945
Arb 3334-87 T. D.
7" Casing set at 3336 Rust.

1/13 T.D. 3340'
85' oil 15 hrs.
Gravity 22.1

1/20 2500 acid swab 4 bbls oil per
hr trace water 7 hrs SD.

1/27 Lans 2945
Arb 3334
7" @ 3336'
T.D. 3340'
2500 gals. acid water
Perf. Lansing water

ABANDONED

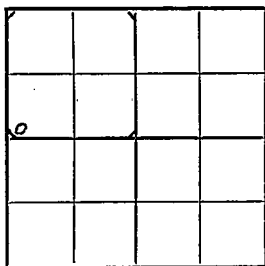
KANSAS

Russell

Map No. 72 Sec. 26 Twp. 11 R. 15 WWell No. 1 EulertDickey Oil CompanyFIRST REPORT Contractor

SW NW

SECTION PLAT

 Ft. from N. Line330 Ft. from S. Line Ft. from E. Line330 Ft. from W. Line

WILDCAT

Location Rig up

Drilling and Remarks:

10"-620'

Anhy. 945'

Dr1g. 1215'

RECORD

Cased in., ft.Sand Gas Oil Total Depth

PRODUCTION

1st 24 hrs. Nat. 1st 24 hrs. after shot Gas Cu. Ft.Dry Hole Abandoned

Date

DEC 22 1942 19 S. J. LEWIS Scout

KANSASMap No. 72 Sec. 26 Twp. 11 R. 15WWell No. 1 EulertDickey Oil

Company

ABANDONED

Contractor

SW NW

SECTION PLAT

 Ft. from N. Line330 Ft. from S. Line Ft. from E. Line330 Ft. from W. Line

0			

WILDCATLocation Rig up

Drilling and Remarks:

*Line 2945**Cr 43384**7" O3236**2500 acid Water**Perforated casing*
Water

RECORD

Cased in., ft.Sand Gas Oil Total Depth 3340

PRODUCTION

1st 24 hrs. Nat. 1st 24 hrs. after shot Gas Cu. Ft.Dry Hole Abandoned

Date

JAN 27 1943

19

S. J. LEWIS

Scout