

Section 26 Township 11 Range 18 W

Well No. # 1 Jacobs

Company Lee Phillips Oil

NORTH

0							

WEST

EAST

SOUTH

12

Ellis

KANSAS

Sec. 26 Twp. 11 R. 18.1

Well No. #1 Jacobs Farm

Lee Phillips Oil Company

Transit - Contr. Contractor


Wildcat

330' Ft. from N. Line

_____ Ft. from S. Line

_____ Ft. from E. Line

330' Ft. from W. Line

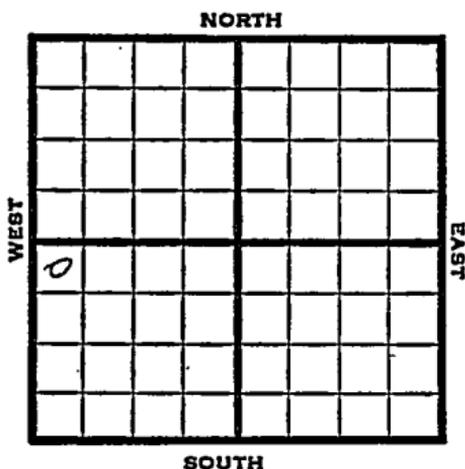

NW NW SW

1951 Elev. 2111' REPORT

9/26
10/17

Location
Spud 10-1-51
D&A TD 3775
8" @ 214
Top. 3101 Heeb. 3332
Tor. 3352 Lans. 3374
BKC 3567 Cong. 3641
Arb. 3737-75 TD
D&A

ABANDONED

