


KANSAS

Section 26 Township 11 Range 18W

Well No. 4 Ancobs

Company Phillips

Burnett Pool  
NORTH

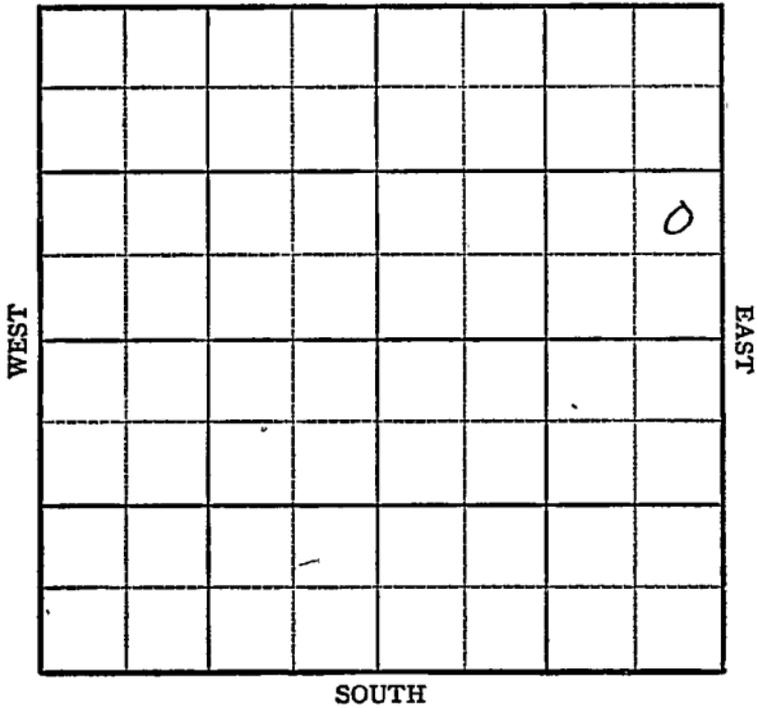

**KANSAS**

Ellis

Sec. 26 Twp. 11 R. 18W ✓

Well No. #4 Ancobs Farm  
Phillips Company  
Burnett Pool


\_\_\_\_\_ Ft. from N. Line

990' Ft. from S. Line

330' Ft. from E. Line

\_\_\_\_\_ Ft. from W. Line

NE SE NE

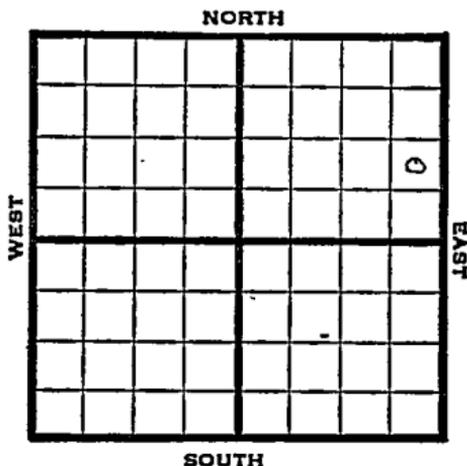

1948 **Eli 1997' REPORT**

9/8	Location
9/14	"
9/21	"
9/29	RUR
10/6	8" @ 1314'
10/13	Drlg 3350' -
10/19	Lansing-3256'
	Arb. 3564-66'
	TD 3566'
	5" @ 3563
	RUST
10/26	500 acid
	Swb 22 bbls oil / 30 W in 5 hrs
11/3	"
11/10	"
11/16	"
11/23	"
11/30	"
12/8	TD 3566'
	Arb. 3564'
	5" @ 3563' 500 acid
	Pump 76 oil / 254 W Pot
	36° Gr.
	Comp
	<b>COMPLETED</b>

Ellis County Kansas State

Map No. \_\_\_\_\_ Sec. 26 Twp. 11 R. 18W

Well No. 4 Ancobs

Phillips Company

FIRST REPORT Contractor  
NE SE NE

SECTION PLAT

\_\_\_\_\_ Ft. from N. Line

990 Ft. from S. Line

330 Ft. from E. Line

\_\_\_\_\_ Ft. from W. Line

							o

Burnett Pool

Remarks:

Location

7

Date SEP 8 1948

Scout S. J. LEWIS

