

Ellis

KANSAS

JAS

19W

26


11

Section _____ Township _____ Range _____

Well No. #3 Vine "A"Company Jones, Shelburne & Farmer

NORTH

WEST

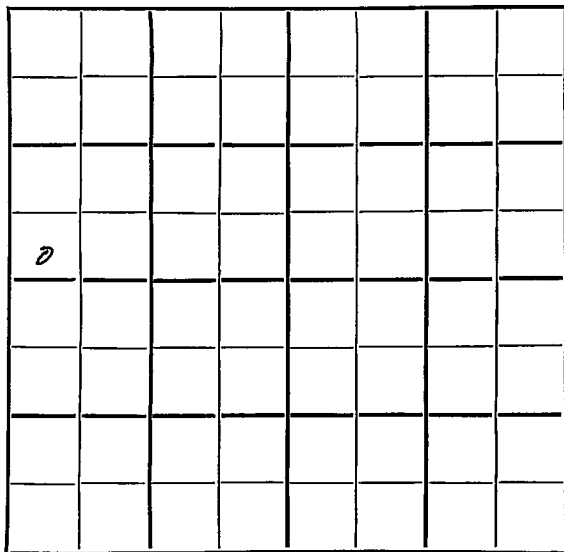

EAST

SOUTH

Ellis

Sec. 26 Twp. 11 R. 19WWell No. #3 Vine "A" FarmJones, Shelburne & Farmer Company

Contractor


Ft. from N. Line

330 Ft. from S. Line

Ft. from E. Line

330 Ft. from W. Line

SW SW NW

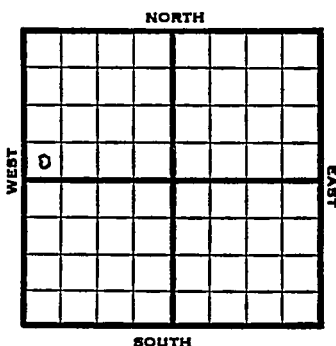

1953 Elev. 2098' REPORT

1/28 Spud 1-20-53
 8" @ 165
 Anhy 1402
 Drlg. 3270

2/5 Heeb 3278' Tor 3295' Lans 3317'
 B KC 3542' Simp 3584' Arb. 3600
 RTD 3608' 5" @ 3607

2/12 CO 3608' S/10 BOPH 4 hrs 1000 A
 S/25 BOPH 3 hrs. POP

2/19 NR

2/25 Spud 1-20-53 Oil well TD 3608
 8" @ 165 Anhy 1403 Heeb 3278
 Tor 3296 Lans 3317 B KC 3542
 Simp 3584 Arb. 3600 TD 3608
 5" @ 3607 CO to 3608 S/10 BOPH
 4 hr. 1000 A S/25 BOPH 3 hr.
 Comp. 1799 BOPD

COMPLETED

County Ellis State Kansas
 Sec. 26 (Blk. 11 (Sur. 19W Map No. 11)
 Operator Jones, Shelburne & Farmer
 Well No. 3 Farm Vine "A"
 Elev. _____ Location SW SW NW

330 Ft. From S Line NW
 330 Ft. From W Line Quarter

1st. Report JAN 28 1953

Completion _____

Remarks _____

Spudding Date 1-20-53

Drlg. Data

8" @ 165 Anhy 1402 drlg. 3270

J. G. McGEHEE

County Ellis State Kansas

Sec. 26 (Blk. Twp.) 11 (Sur. Rge.) 19W Map No.

Operator Jones, Shelburne & Farmer

Well No. 3 Farm Vine "A"

Elev.	2098	Location	SW SW NW
-------	------	----------	----------

0

COMPLETE

330 Ft. From S Line NW

330 Ft. From W Line Quarter

1st. Report

Completion FEB 25 1953

Remarks

Spudding Date 1-20-53

Drlg. Data Oil well TD 3608

8" @ 165 Anhy 1403 Heeb. 3278

Tor. 3295. Lens. 3317 B KC 3542

Simp. 3584 Arb. 3600 TD 3608

5" @ 3607 CO to 3608 S/ 10 boph 4 hr.

1000 A S/ 25 boph 3 hr.

Comp. 1799 bopd

J. G. McGEHEE