


Section 26 Township 11 Range 19W

Well No. #1 Herb Vine

Company Jones, Shelburne & Farmer

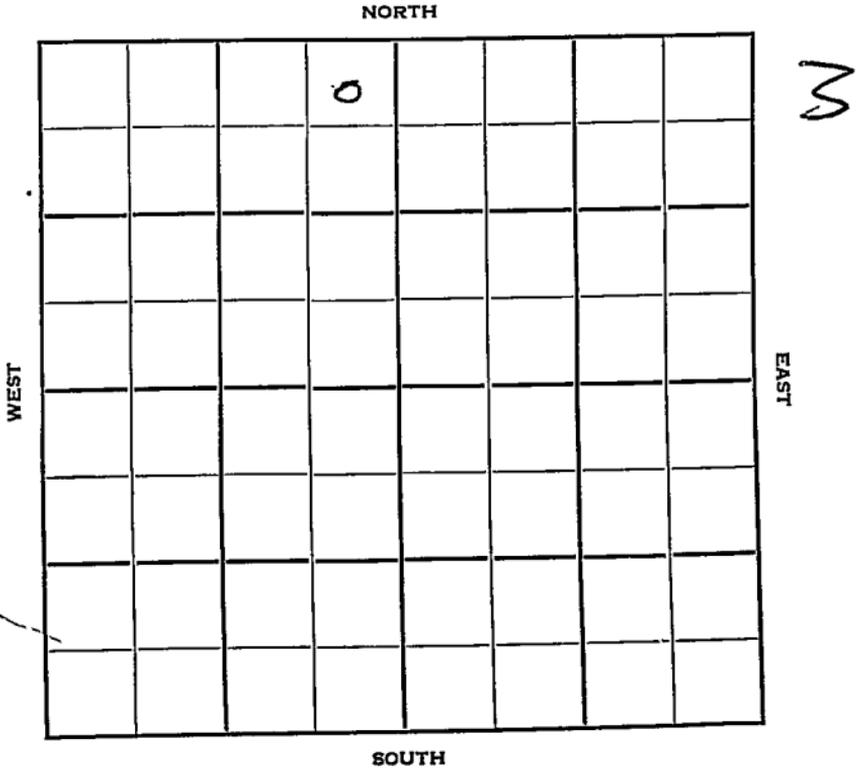

Ellis

KANSAS

Sec. 26 Twp. 11 R. 19N

Well No. #1 Herb Vine Farm

Jones, Shelburne & Farmer Company

J-S-F Contractor


330 Ft. from N. Line

Ft. from S. Line

330 Ft. from E. Line

Ft. from W. Line

NW 1/4 NE NE NW

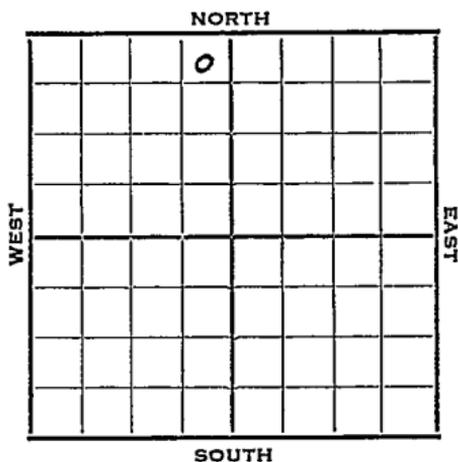

1952 Elev. 2082' REPORT

10/29

MTM

11/5

8" @ 163'

Anhy 1385'

Erlg. 2750'

11/12

Heeb. 3258 Tor. 3276

Lans. 3297

DST 3376-91, 1 hr. 365' SW

1140# BKG 3521 Marm 3544

Simp. 3565 Arb. 3572

DST 3574-86, 1 hr. 2400' oil

1000 A TD 3586

5" @ 3574'

11/20

CO S/50 BOPH 1500' off btm

11/26

Spud 10-29-52

Oil well TD 3586' 8" @ 163

Anhy ~~1385~~ 1385' Heeb 3258' Tor 3276

Lans. 3297'

DST 3376-91 open 1 hr. rec 365' SW

1140# B KG 3521' Marm. 3544'

Simp. 3565' Arb. 3572'

DST 3574-86 open 1 hr. rec 2400' oil

1000# TD 3586' 5" @ 3574

S/50 BOPH

Comp. 3000 BOPD

COMPLETED


County Ellis State Kansas

Sec. 26 (Blk. Twp.) 11 (Sur. Rge.) 19W Map No.

Operator Jones, Shelburne & Farmer

Well No. 1 Farm Herb Vine

Elev. _____ Location NE NE NW

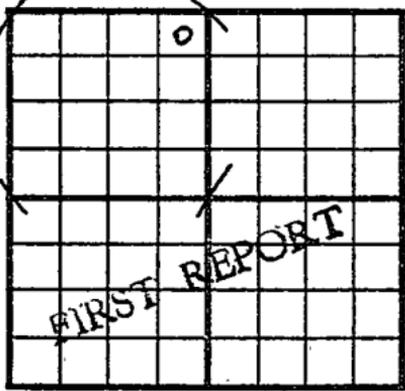

330 Ft. From N Line NW

330 Ft. From E Line Quarter

1st. Report OCT 29 1952

Completion _____

Remarks _____

J-S-F = Contr.

Spudding Date _____

Drig. Data _____

M I M


County Ellis State Kansas

Sec. 26 (Blk. 11) (Sur. 19W) Twp. (Rge.) Map No.

Operator Jones, Shelburne & Farmer

Well No. 1 Farm Herb Vine

Elev. 2082 Location NE NE NW

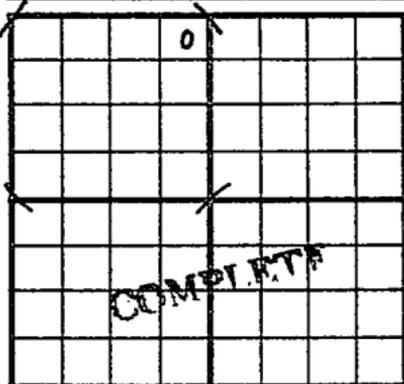

330 Ft. From N Line NW

330 Ft. From E Line Quarter

1st. Report

Completion NOV 26 1952

Remarks

J-S-F - Contr.

Spudding Date 10-29-52

Drlg. Data Oil well TD 3586

8" @ 163 Anhy 1385 Heeb. 3258

Tor. 3276 Lans. 3297 DST 3376-91

open 1 hr. Rec. 365' sw 1140#

B KC 3521 Marm. 3544 Simp. 3565

Arb. 3572 DST 3574-86 open 1 hr.

Rec. 2400' oil 1000# TD 3586

5" @ 3574 S/ 50 both

Comp. 3000 bond