

FORM 51


Ellis

KANSAS

Section 26 Township 11 Range 19W

Well No. #2 Glathart

Company G & G Drlg.

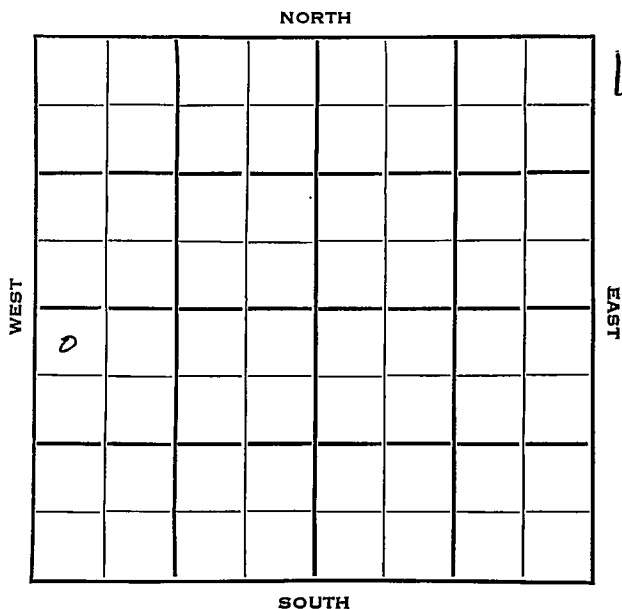



Sec. 26 Twp. 11 R. 19 W

Well No. # 2 Glathart Farm _____

C & G Drlg. Company _____

C & G Drlg. Contractor _____


330 Ft. from N. Line

_____ Ft. from S. Line

_____ Ft. from E. Line

330 Ft. from W. Line

NW NW SW

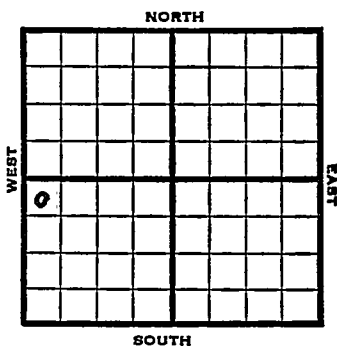

1953

Elev. 2104' REPORT

2/25 Cellar & Pits
 3/12 " "
 3/19 " "
 3/26 " "
 4/2 " "
 4/9 8" @ 165'
 Drlg 2286'
 4/16 Heeb 3275, Tor 3293, Lans 3326, Arb. 3611,
 RTD 3615
 5" @ 3612
 4/23 CO 3615, DD 3617, FU 1500' oil
 3 hrs., 500A
 S/20 boph 2 hrs., POP
 4/30 NR
 5/7 NR
 5/20 Spud 4-1-53 Oil well TD 3615
 8" @ 165 Top 3058 Heeb 3285
 Tor. 3303 KC 3325 B KC 3550
 Simp. 3595 Arb. 3611
 TD 3615 5" @ 3612 GO to 3615
 DD 3617 FU 1500' oil 3 hr. 500 A
 S/20 BOPH 2 hr.
 Comp. 3000 BOPD

COMPLETED

