

Ellis

FORM 51

KANSAS

Section 26 Township 11 Range 19W

Well No. #3 Glathart

Company C & G Drlg.

NORTH

								12
WEST								EAST
	0							

SOUTH

Ellis

KANSAS


SEC.	TWP.	R.
26	11	19 W ✓

WELL NO. # 3 Glathart FARM

COMPANY C & G Drlg.

CONTRACTOR

990 \_\_\_\_\_ Ft. from N. Line  
 \_\_\_\_\_ Ft. from S. Line  
 \_\_\_\_\_ Ft. from E. Line  
 990 \_\_\_\_\_ Ft. from W. Line

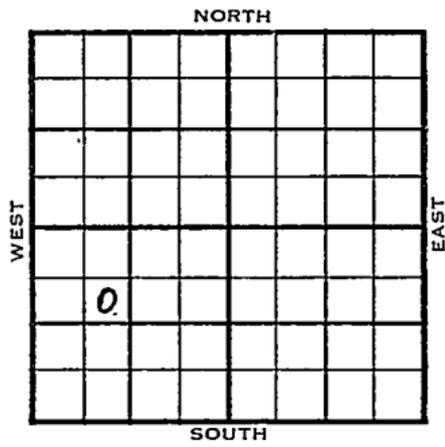

SE NW SW

1954	ELEVATION	REPORT
	2116'	

1/6 Spud 12-31-53  
 8" @ 190  
 Anhy 1430'  
 Fsg. 3275'

1/13 Top 3081' Heeb 3310' Tor. 3328'  
 Lans. 3350' B KC 3578' Cong. 3598'  
 Simp. 3616' Arb. 3639'  
 RTD 3643' 5" @ 3639 CO 3643'  
 S/10 BOPH 3½ hrs.

1/20 500A, POP

1/27 NR

2/10 Spud 12-31-53 Oil well TD 3643  
 8" @ 190 Anhy 1430 Top 3081  
 Heeb 3310 Tor 3328 Lans 3350  
 B KC 3578 Cong 3598 Simp 3616  
 Arb. 3639 TD 3643 5" @ 3639  
 CO to 3643 S/10 BOPH 3½ hr. 500 A  
 Comp. 530 BOPD

**COMPLETED**

County **Ellis** State **Kansas**

Sec. **26** (Blk. Twp.) **11** (Sur. Rge.) **19W** Map No.

Operator **C. & G Drlg.**

Well No. **3** Farm **Glathart**

Elev. Location **SE NW SW**

FIRST REPORT							

**990** Ft. From **N** Line **SW**

**990** Ft. From **W** Line Quarter

1st. Report **JAN 6 1954**

Completion

Remarks

Spudding Date **12-31-53**

Drlg. Data  
**8" @ 190 Anhy 1430 fsg. 3275**

County Ellis State Kansas

Sec. 26 (Blk. 11) (Sur. 19W) (Twp.) (Rge.) Map No.

Operator C & G Drlg.

Well No. 3 Farm Glathart

Elev. 2116 Location SE NW SW


990 Ft. From N Line SW

990 Ft. From W Line Quarter

**COMPLETE**

1st. Report

Completion FEB 10 1954

Remarks

Spudding Date 12-31-53

Drlg. Data Oil well TD 3643

8" @ 190 Anhy 1430 Top. 3081

Heeb. 3310 Tor. 3328 Lans. 3350

B KC 3578 Cong. 3598 Simp. 3616

Arb. 3639 TD 3643 5" @ 3639 CO to 3643

S/ 10 boph 3 1/2 hr. 500 A

Comp. 530 bopd