


Section 26 Township 11 Range 19 W

Well No. # 4 Vine "A"

Company Jones, Shelburne & Farmer

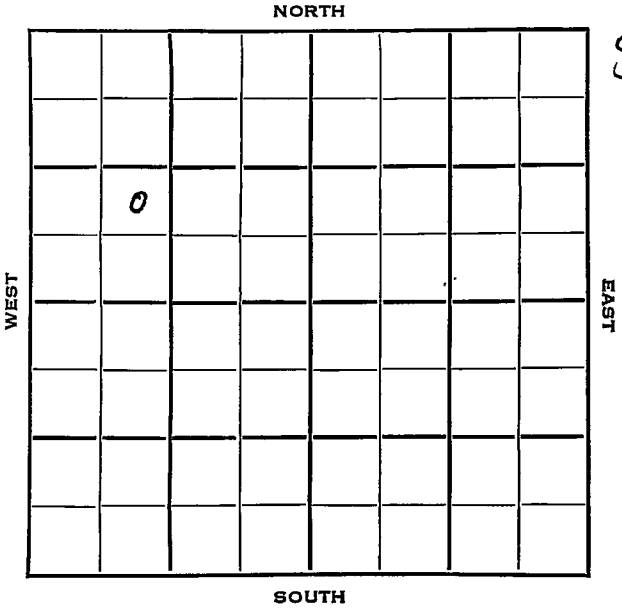



Sec. 26 Twp. 11 R. 19W

Well No. #4 Vine "A" Farm

Jones, Shelburne & Farmer Company

J-S-F Contractor

Solomon Pool


Ft. from N. Line

990 Ft. from S. Line

Ft. from E. Line

990 Ft. from W. Line

NE SW NW

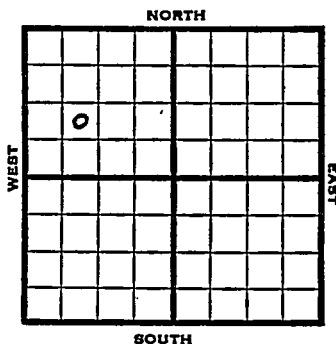

1953 Elev. 2123' REPORT

4/15 Location

4/23 8" @ 155  
Anhy 1419  
Drlg. 3240'

4/30 Heeb 3298, Tor 3315, Lans 3338, B KC 3567, Simp 3605, Arb. 3620  
RTD 3626  
5" @ 3622

5/7 CO 3626 S/35 BOPH 2 hrs 1000 A  
oil inc. POP

5/21 NR

5/27 Spud 4-14-53  
Oil Well  
TD 3626'  
8" @ 155'  
Anhy 1419, Heeb 3298, Tor 3315, Lans 3338, B KC 3567, Simp 3605, Arb 3620  
TD 3626'  
5" @ 3622'  
CO to 3626 S/ 35 boph 2 hr.  
1000 A  
Comp. 3000 bopd.

**COMPLETED**



