


Section 26 Township 11 Range 19W

Well No. #8 Vine (Vine "A")

Company Jones, Shelburne & Farmer

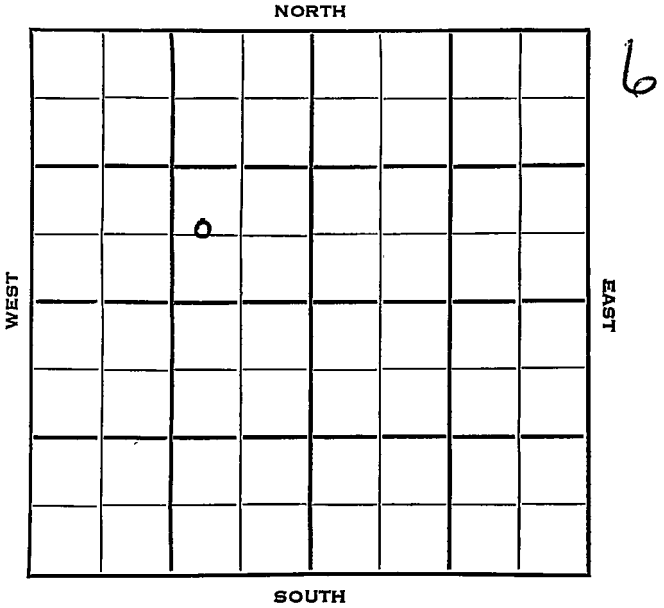

Sec. 26 Twp. 11 R. 19W

Well No. #8 Vine "A" Farm

Jones, Shelburne & Farmer Company

Contractor


 Ft. from N. Line

700 Ft. from S. Line

990 Ft. from E. Line

 Ft. from W. Line

NW SE NW

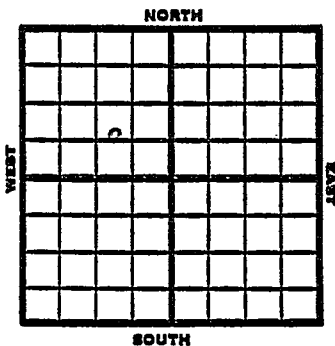

1953 Elev. 2113' REPORT

8/2 MIM
 9/9 NR
 9/16 "
 9/23 Drlg. 2735'
 9/30 Heeb 3285, Tor 3303, Lans 3322, Arb 3608'
 RTD 3615'
 5" @ 3610'
 10/7 CO 3615' S/35 BOPH 4 hrs. 600' OB 500 A
 10/14 NR
 10/21 Spud 9-18-53
 Oil Well
 TD 3615
 Heeb 3285, Tor 3303, Lans 3322, Arb. 3608
 TD 3615
 5" @ 3610
 CO to 3615
 S/35 boph 4 hrs. 500A
 Comp. 3000 bopd

COMPLETED

