
FORM 51 Ellis KANSAS

Section 26 Township 11 Range 19W

Well No. 1 Vine "B"

Company Jones, Shelburne & Farmer

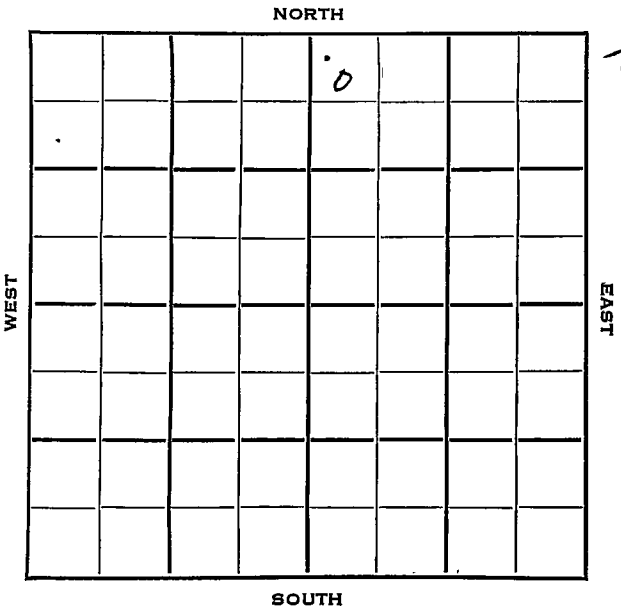

FORM 252-B

Ellis KANSAS

Sec. 26 Twp. 11 R. 19 W

Well No. # 1 Vine "B" Farm

Jones, Shelburne & Farmer Company

Contractor


330 Ft. from N. Line

Ft. from S. Line

Ft. from E. Line

330 Ft. from W. Line

NW NW NE

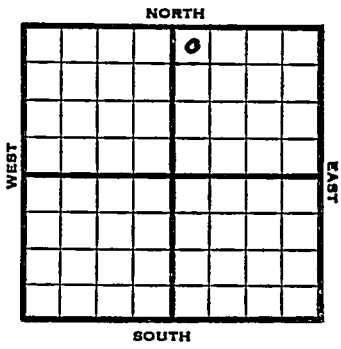

1952	Elev. 2060' REPORT
12/10	Drlg. 730'
12/11	Ø730
12/18	HEEB 3247 Tor 3265 Lans 3285 Ø3410
12/25	" " " " " "
1/1	Arb 3565-75 RTD 5" @ 3567 CO 3575 2 BOPH 1000A s/10 BOPH 5 hrs. POP
1/8	NR
1/22	NR
1/29	"
2/5	NR
2/12	NR
2/19	NR
2/25	Spud 12-12-52 Oil well TD 3575 8" @ 1268 Heeb 3247 Tor 3265 Lans 3285 Arb. 3565-75 5" @ 3567 CO to 3575 S/2 BOPH 4 hr. 1000 A S/10 BOPH 5 hr. Comp. 169 BOPD

COMPLETED

FORM 275 FOR SALE BY KANSAS BLUE PRINT CO.


County Ellis State Kansas

Sec. 26 (Blk. Twp.) 11 (Sur. Rge.) 19W Map No.

Operator Jones, Shelburne & Farmer

Well No. 1 Farm Vine "B"

Elev. Location NW NW NE

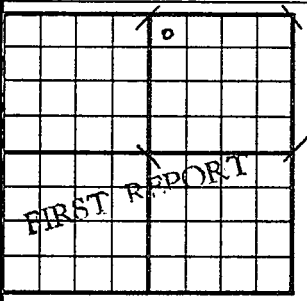

330 Ft. From N Line NE

330 Ft. From W Line Quarter

1st. Report DEC 10 1952

Completion

Remarks

Spudding Date

Drlg. Data

drlg. 730

J. G. McGEHEE

FORM 275 FOR SALE BY KANSAS BLUE PRINT CO.


County Ellis State Kansas

Sec. 26 (Blk. Twp.) 11 (Sur. Rge.) 19W Map No.

Operator Jones, Shelburne & Farmer

Well No. 1 Farm Vine "B"

Elev. 2060 Location NW NW NE

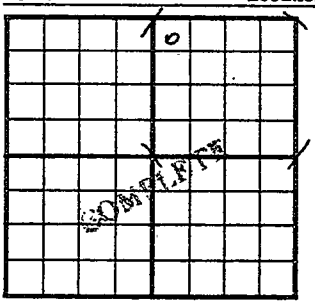

330 Ft. From N Line NE

330 Ft. From W Line Quarter

1st. Report

Completion FEB 25 1953

Remarks

Spudding Date 12-12-52

Drlg. Data Oil well TD 3575

8" @ 1268 Heeb. 3247 Tor. 3265

Lans. 3285 Arb. 3565-75 5" @ 3567

CO to 3575 S/ 2 boph 4 hr. 1000 A

S/ 10 boph 5 hr. Comp. 169 bopd

J. G. McGEHEE