

Section 26 Township 11 Range 19W

Well No. #3 Vine B

Company Jones, Shelburne & Farmer

NORTH

					0		

2

WEST

EAST

SOUTH

# Ellis KANSAS


SEC. <div style="text-align: center;">26</div>	TWP. <div style="text-align: center;">11</div>	R. <div style="text-align: center;">19 W</div>
---	---	---

WELL NO. FARM  
# 3 Vine "B"

COMPANY  
Jones, Shelburne & Farmer

CONTRACTOR  
Co. tools  
 Solomon Pool

330 \_\_\_\_\_ Ft. from N. Line  
 \_\_\_\_\_ Ft. from S. Line  
 \_\_\_\_\_ Ft. from E. Line  
 990 \_\_\_\_\_ Ft. from W. Line

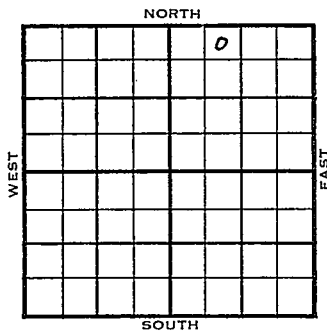

NE NW NE

1954	ELEVATION	REPORT
------	-----------	--------

9/1	Spud 8-17-54 8" @ 180 Heeb 3212 Tor. 3231 Lans. 3250 Arb. 3542 DST 3542-47 open 1/2 hr rec 30' SOCM 940# DST 3547-52 open 1 hr rec 30' gas 120' gassy oil, 90' OCM 945# DST 3567-3604 open 1/2 hr rec 2100' SW 930# Drlg. 4061'	
9/29	Spud 8-17-54 Oil Well TD 4061' 8" @ 180' Heeb 3212', Tor 3231', Lans 3250' Arb 3542' DST 3542'-47' opn 1/2 hr, rec 30' socm rec 30' socm, 940# DST 3547'-52' opn 1 hr, rec 30' gas, 120' gassy oil, 90' ocm, 945# DST 3567'-3604' opn 1/2 hr, rec 2100' sw 930# TD 4061' 5" @ 3582' CO 10/ 3542-44 16/ 3546-50 300 A S/ 20 boph Comp 132 bopd 3% Wtr.	COMPLETED



