


Section 26 Township 11 Range 19W

Well No. #5 Vine "B"

Company Jones, Shelburne & Farmer

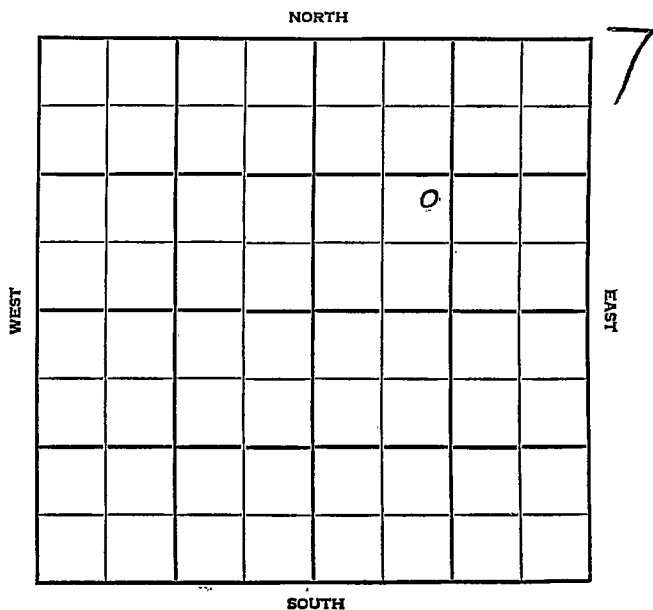

Ellis

KANSAS

SEC.	TWP.	R.
26	11	19 W


WELL NO. # 5 Vine "B" FARM

COMPANY Jones, Shelburne & Farmer

CONTRACTOR

Solomon

_____ Ft. from N. Line
 _____ Ft. from S. Line
 _____ Ft. from E. Line
 _____ Ft. from W. Line

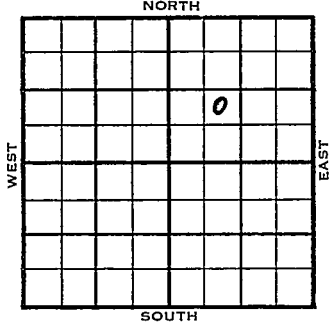

NE SW NE

1955	ELEVATION	REPORT
------	-----------	--------

6/22

Comm. 5-3-55
 8-5/8" @ 162/100 5 1/2" @ 3630
 CO to 4074 Comp. SWD well 250 BWPH
 Any 1370', H. 3252', Tr. 3268',
 L. 3291', -B KC 3519', C 3539'
 A. 3577'
 TD 4074'

FIRST REPORT

~~ABANDONED~~

County Ellis Elev. 2036 Co.
 Sec. 26 Twp. 11 Rge. 19W
 Company Jones, Shelburne & Farmer
 Farm Name Vine "B" No. 5

TOPS	DEPTH	LOG	DATUM
Anh.	<u>1370</u>		
TP.			
H.	<u>3252</u>		<u>1216</u>
Tr.	<u>3268</u>		<u>1233</u>
Dg.			
BL.			
L.	<u>3291</u>		<u>1255</u>
K.C.			
B.K.C.	<u>3519</u>		<u>1483</u>
Ce.			
C.	<u>3539</u>		<u>1503</u>
M.			
M.			
K.			
Mz.			
Mq.			
V.			
S.			
S.			
A	<u>3577</u>		<u>1541</u>
R.			
PE.			
G.			
TD.	<u>4074</u>		

Loc. in Sec. NE SW NE
 Geol. _____
 Contr. _____
 Pool Solomon

**FIRST REPORT
 ABANDONED**

Date Comm. 5-3-55 JUN 22 1955
8 5/8" @ 162.100 5 1/2" @ 3630
CO to 4074 Comp. SWD well 250 bwph

Co.
 Lse.
 No.
 Sec.
 T.
 R.