

# KANSAS


Form 51-5M-7-39-Palace

Ellis

Section 26 Township 11 Range 17-W

Well No. 13 Hall "B"

Company Cities Service Oil

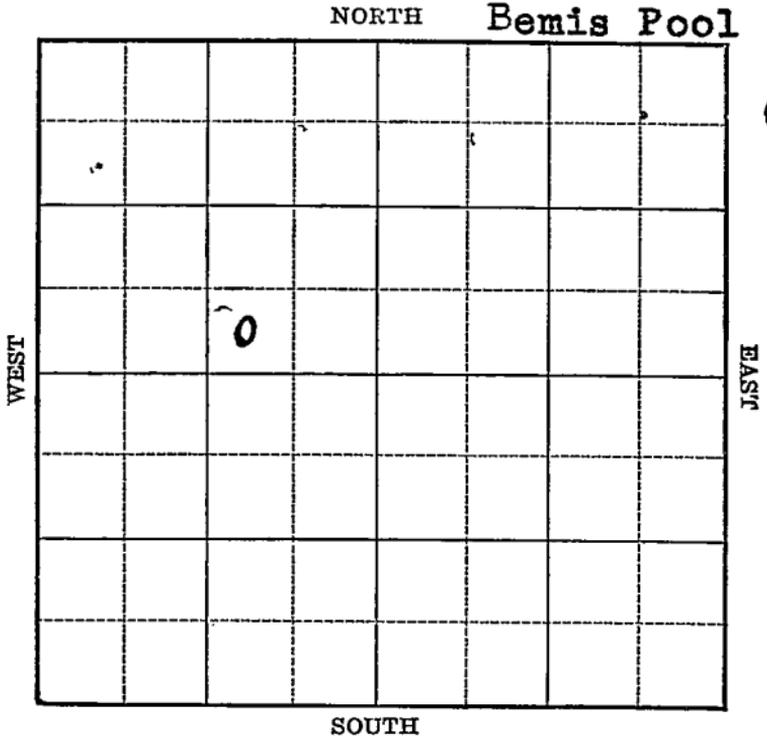

Sec. 26 Twp. 11 R. 17-W

Well No. #13 Hall "B" Farm

Cities Service Oil Company


(Bemis)

\_\_\_\_\_ Ft. from N. Line

330 Ft. from S. Line

990 Ft. from E. Line

\_\_\_\_\_ Ft. from W. Line

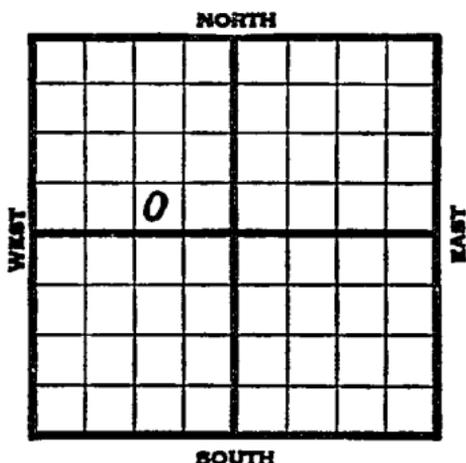

Elev. 2062

1940	REPORT
1/31	Location
2/8	"
2/15	R.U.R.
2/23	10" - 1125' Drlg. 1200'
2/29	Drlg. 2977'
3/8	Arb. <sup>3522</sup> <del>3524</del> ' T.D. 3530'
3/14	Arb. 3522' (Corrected)
	5" - 3523' T.D. 3528'
	2300' oil 3 hours. 500 acid.
3/20	Arb. 3522'
	5" - 3523'
	T.D. 3528'
	500 acid.
	Depthograph 4230 bbls.
	Maximum 3000 bbls.
	<b>COMPLETED</b>

Map No. 7/ Sec. 26 Twp. 11 R. 17W

Well No. 13 Hall "B"

Cities Service Oil Company

Contractor

**FIRST REPORT**

SW SE NW

**SECTION PLAT**

         Ft. from N. Line

330 Ft. from S. Line

990 Ft. from E. Line

         Ft. from W. Line

	o		'

**BEMIS POOL**

Location X

Rig up         

Drilling and Remarks:         

**RECORD**

Cased          in.,          ft.

Sand         

Gas         

Oil         

Total Depth         

**PRODUCTION**

1st 24 hrs. Nat.         

1st 24 hrs. after shot         

Gas          Cu. Ft.

Dry Hole         

Abandoned         

Date

JAN 31 1940

S. J. LEWIS

Scout

Map No. 71 Sec. 26 Twp. 11 R. 17WWell No. 13 Hall "B"Cities Service Oil Company

Contractor

## COMPLETED

SW SE SW

\_\_\_\_\_ Ft. from N. Line

330 Ft. from S. Line990 Ft. from E. Line

\_\_\_\_\_ Ft. from W. Line

## SECTION PLAT

	0		

## BEMIS POOL

Location \_\_\_\_\_

Rig up \_\_\_\_\_

Drilling and Remarks:

*Cu 83522.**5" @ 3523**5000 cu ft**Depthograph 4230.**Maximum 3000.*

## RECORD

Cased \_\_\_\_\_ in., \_\_\_\_\_ ft.

Sand \_\_\_\_\_

Gas \_\_\_\_\_

Oil \_\_\_\_\_

Total Depth 3528.

## PRODUCTION

1st 24 hrs. Nat. \_\_\_\_\_

1st 24 hrs. after shot \_\_\_\_\_

Gas \_\_\_\_\_ Cu. Ft.

Dry Hole \_\_\_\_\_

Abandoned \_\_\_\_\_

Date

MAR 20 1940 19

S. J. LEWIS Scout