


Section 26 Township 11 Range 17 W

Well No. # 24 Hall "B"

Company Cities Service

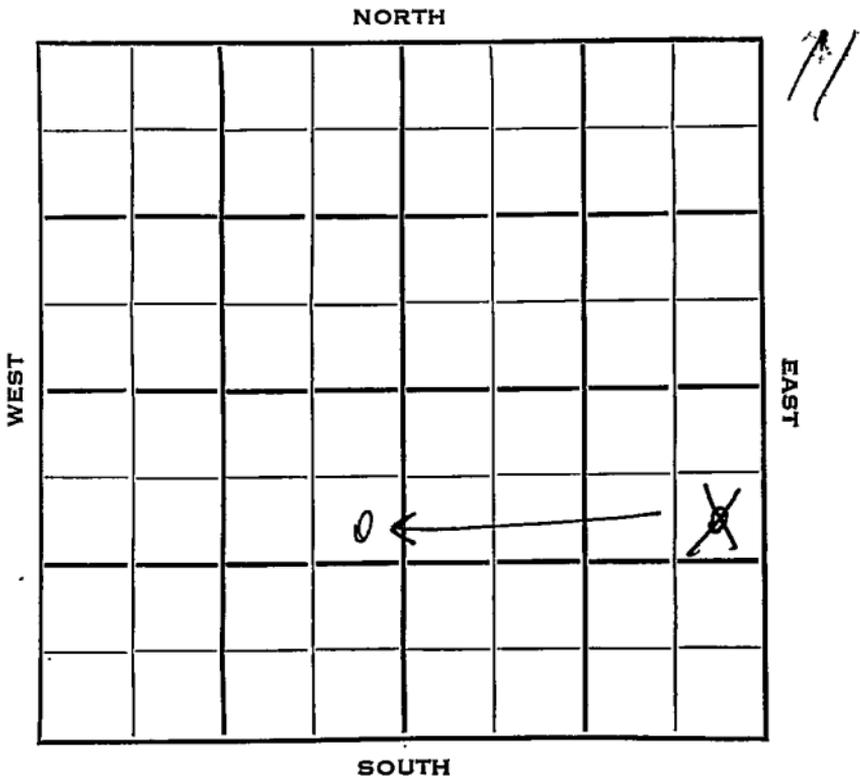



Sec. 26 Twp. 11 R. 17W

Well No. #24 Hall "B" Farm

Cities Service Company

Nye Drlg. Contractor


~~825~~
~~990~~ Bemis-Shutts Pool
Ft. from N. Line

Ft. from S. Line

~~405~~
~~330~~ Ft. from E. Line

Ft. from W. Line

~~SE NE SW~~
~~SE NE SE~~

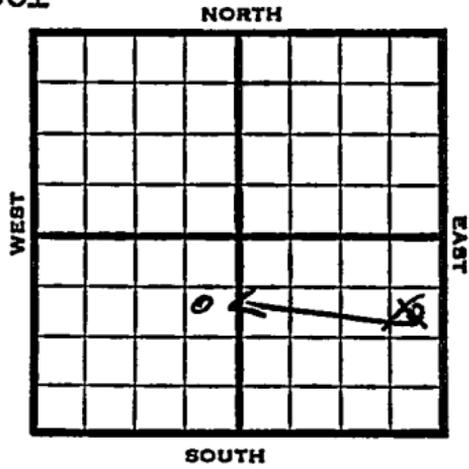

1953 Elev. 2033' REPORT

7/22 Location

7/29 Anhy 1214'

8/5 8" @ 1230
Drlg. 3205'

8/12 Top 2982' Heeb 3179' Dodge 3202
Lans 3231 Arb. 3520
DST 3521-25, 1 hr, 30' SMCO, 155' M & W, 500#
DST 3551-54, 1 hr, 7' M RTD 3554
5" @ 3554

8/19 NR

9/2 Spud 7-26-53

Oil Well

TD 3556

Anhy 1214

8" @ 1230

Top 2982, Heeb 3179, Dodge 3202,
Lans 3231, Arb. 3520

DST 3521-25, opn 1 hr., rec. 30'
smco, 155' mud & wtr, 500#

DST 3551-54, opn 1 hr., rec. 7' mud,
O#

TD 3554

5" @ 3554

DD 3556, mud & so, FU 24' oil 1 hr.,

250A, P/103 bo 64 bwpd

Comp. 55 bopd 67 bw

COMPLETED

Kansas

Map No. _____ Sec. 26 Twp. 11 R. 17W

Well No. 24 Hall "B"

Cities Service

Company

CORRECTION

Contractor

SE NE SW

SECTION PLAT

825 Ft. from N. Line

_____ Ft. from S. Line

405 Ft. from E. Line

_____ Ft. from W. Line

Ellis County

Location _____

Rig up _____

Drilling and Remarks:

Reported
SE NE SE

RECORD

Cased _____ in., _____ ft.

Sand _____

Gas _____

Oil _____

Total Depth _____

PRODUCTION

1st 24 hrs. Nat. _____

1st 24 hrs. after shot _____

Gas _____ Cu. Ft.

Dry Hole _____

Abandoned _____

Date

JUL 29 1919

J. G. McGEHEE

Scout

County Ellis State Kansas

Sec. 26 (Blk. 11) (Sur. 17W) (Twp.) (Rge.) Map No.

Operator Cities Service

Well No. 24 Farm Hall "B"

Elev. 2033 Location SE NE SW

COMPLETE					

825 Ft. From N Line SW

405 Ft. From E Line Quarter

1st. Report

Completion SEP 2 1953

Remarks Bemis-Shutts Pool

Nye Drlg. - Contr.

Spudding Date 7-26-53

Drlg. Data Oil well TD 3556

Anhy. 1214 8" @ 1230 Top. 2982

Heeb. 3179 Dodge 3202 Lans. 3231

Arb. 3520 DST 3521-25 open 1 hr.

Rec. 30' smco 155' mud & wtr. 500#

DST 3551-54 open 1 hr. Rec. 7' mud

O# TD 3554 5" @ 3554 DD 3556

mud & so FU 24' oil 1 hr. 250 A

P/ 103 bo 64 bwpd

Comp. 55 bopd 67 bw