


Section 26 Township 11 Range 17-W

Well No. #19, Hall "B"

Company Cities Service Oil Company

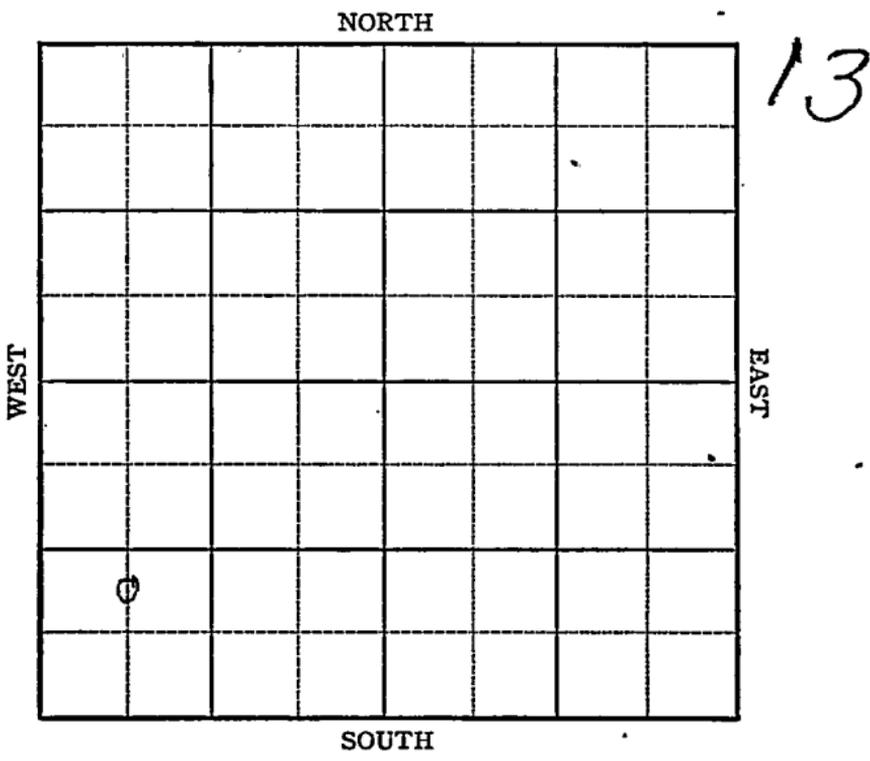

KANSAS

Ellis County



Sec. 26 Twp. 11 R. 17W

Well No. #19 Hall "B" Farm

Cities Service Company

Bemis


Ft. from N. Line

990 Ft. from S. Line

Ft. from E. Line

660 Ft. from W. Line

CNL SW SW

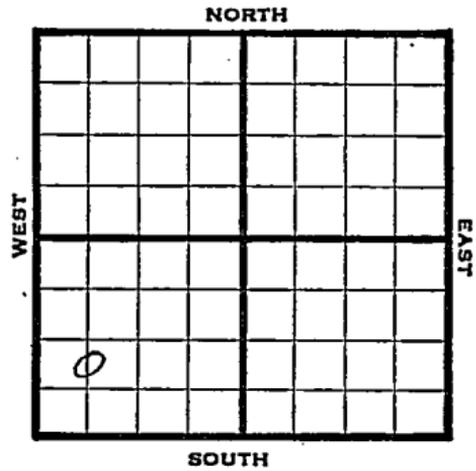

1946 **1956** REPORT

- 7/31 Location
- 8/6 "
- 8/13 "
- 8/20 "
- 8/27 "
- 9/5 Drlg 590'
- 9/10 8" @ 1070  
Drlg 1795'
- 9/18 Drlg 3180'
- 9/24 Arb 3414  
TD 3 508  
RUST
- 10/1 " "
- 10/8 54 shots 3440-61  
1000 acid
- 10/15 Pump 67 oil plus 4% BS&W 24 hrs
- 10/22 3415 to 31 No Increase
- 10/29 " " "
- 11/6 Arb 3419'  
5" @ 3502'  
TD 3507'

ABANDONED

**KANSAS**

Pool Name Bemis

Map No. 77 Sec. 26 Twp. 33 R. 17W

Well No. 19 Hall "B"

Cities Service Company

**FIRST REPORT**

Contractor

C N L SW SW

**SECTION PLAT**

           Ft. from N. Line

990 Ft. from S. Line

           Ft. from E. Line

660 Ft. from W. Line

6			

Ellis County

Location X

Rig up           

Drilling and Remarks:

**RECORD**

Cased            in,            ft.

Sand           

Gas           

Oil           

Total Depth           

**PRODUCTION**

1st 24 hrs. Nat.           

1st 24 hrs. after shot           

Gas            Cu. Ft.

Dry Hole           

Abandoned           

Date

JUL 3 1 1946 19

S. J. LEWIS Scout

