

KANSAS


FORM 51 5M 4-41 PETROL

Ellis

Section 26 Township 11 Range 17-W

Well No. #9 McCord "A"

Company Cities Service Oil

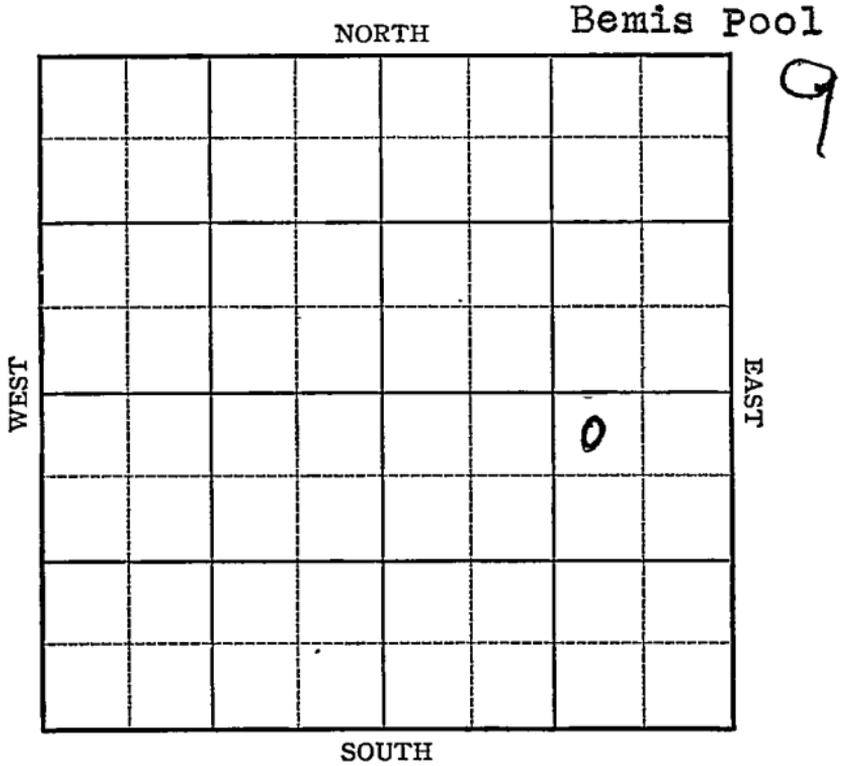

Sec. 26 Twp. 11 R. 17-W

Well No. #9 McCord "A" Farm

Cities Service Oil Company


(Bemis)

330 Ft. from N. Line

_____ Ft. from S. Line

990 Ft. from E. Line

_____ Ft. from W. Line

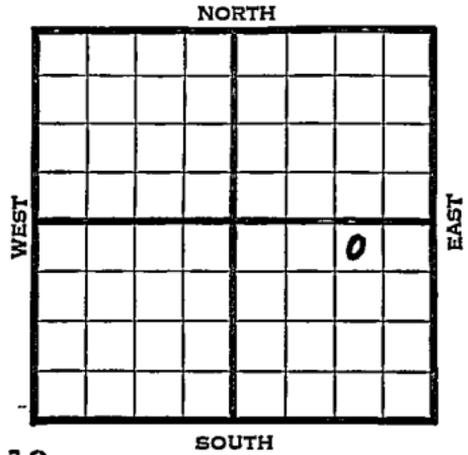

Elev. 2118

1941	REPORT
4/9	Location
4/18	8-5/8" - 1105' WOC.
4/24	Drlg. 2516'
5/1	Arb. ^{3589'} 3580-81' T.D. 5" - 3580'
	RUST.
5/8	Arb. 3589' (Corrected)
	5" - 3589' T.D. 3612'
	2000 acid. Testing.
5/14	Arb. 3589'
	5" - 3589'
	T.D. 3612'
	2000 acid.
	Echometer potential 3048 bbls.
	Maximum 3000 bbls.
	33.5 Gravity
	COMPLETED

Map No. 71 Sec. 26 Twp. 11 R. 17WWell No. 9 McCord "A"Cities Service Oil CompanyFIRST REPORT Contractor

SECTION PLAT

NW NE SE

330 Ft. from N. Line

_____ Ft. from S. Line

990 Ft. from E. Line

_____ Ft. from W. Line

			o

BEMIS POOL

Location X

Rig up _____

Drilling and Remarks:

RECORD

Cased _____ in., _____ ft.

Sand _____

Gas _____

Oil _____

Total Depth _____

PRODUCTION

1st 24 hrs. Nat. _____

1st 24 hrs. after shot _____

Gas _____ Cu. Ft.

Dry Hole _____

Abandoned _____

Date

APR 9 1941 19S. J. LEWIS Scout

Map No. 71 Sec. 26 Twp. 11 R. 17W

Well No. 9 McCord "A"

Cities Service Oil Company

COMPLETED Contractor

SECTION PLAT

NW NE SE

330 Ft. from N. Line

_____ Ft. from S. Line

990 Ft. from E. Line

_____ Ft. from W. Line

			6

BEMIS POOL

Location _____

Rig up _____

Drilling and Remarks:

Cor 83589
5" @ 3589
2000 acul
Ech 1283048
May 3000
335

RECORD

Cased _____ in., _____ ft.

Sand _____

Gas _____

Oil _____

Total Depth 3612

PRODUCTION

1st 24 hrs. Nat. _____

1st 24 hrs. after shot _____

Gas _____ Cu. Ft.

Dry Hole _____

Abandoned _____

Date

MAY 14 1941 19

S. J. LEWIS Scout